


T19S, R37E, W.M.
Harney County, Oregon

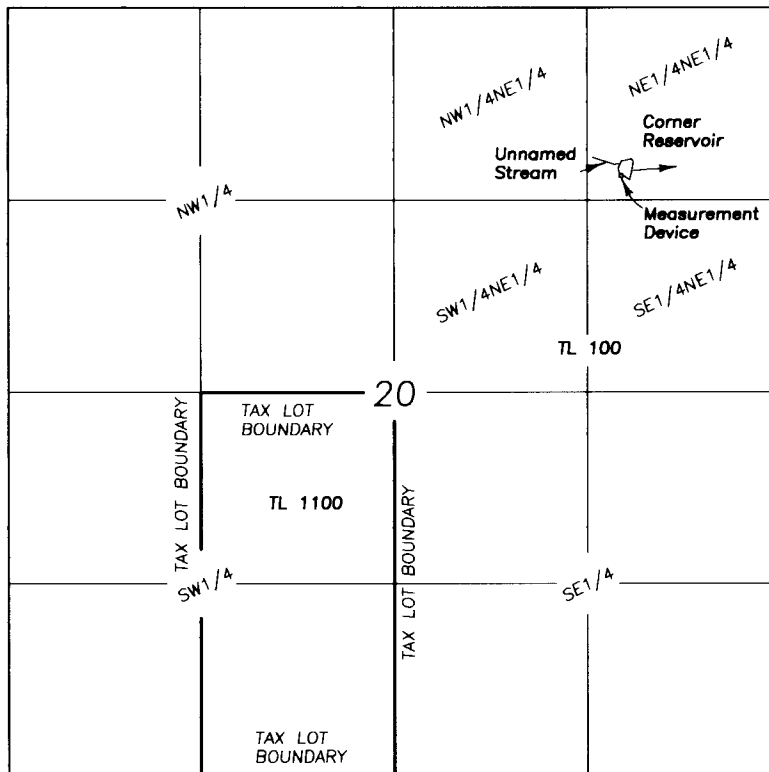

SCALE 1"=1320'

Outlet is located 1140' S & 1080' W of the
NE corner of Section 20.

Measuring device is located 3' North & 4' West of the Outlet

FINAL PROOF SURVEY
CLAIM OF BENEFICIAL USE
CORNER RESERVOIR

For

Bureau of Land Management

October 31, 2016

Prepared by

Cornerstone Surveying, Inc

P.O. BOX 33

JOHN DAY, OR. 97845

(541)575-1813

cornerstonesurvey@centurytel.net

LEGEND

Application No. R-56937

Permit No. R-8016

Priority 12/21/1979

A portion of Tax Lot
19-37 TL100

NOTE: Tax Lot 100 is owned by the BLM
and is more that 16,000 acres.
Therefore only a portion of the tax
lot boundary can be shown.

NOTE: The preparation of this map
was for the purpose of identifying
the location of the proposed water
right and has no intent to provide
dimensions or location of property
ownership lines.

