


T19S, R35E, W.M.
Harney County, Oregon

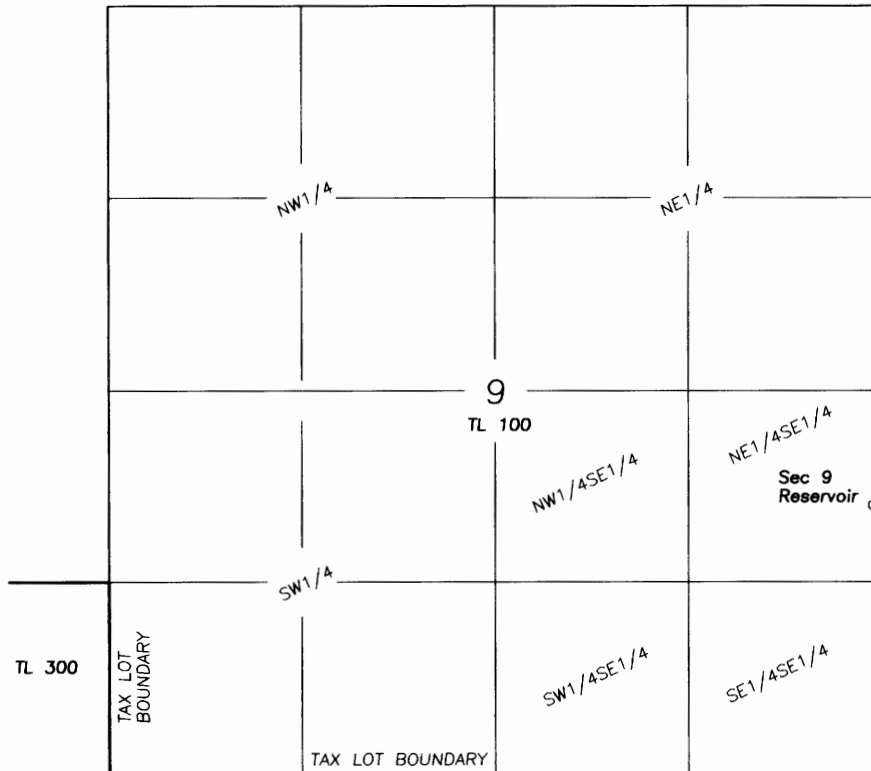

SCALE 1"=1320'

Reservoir is located 1840' N & 30' W of the
SE corner of Section 9.

FINAL PROOF SURVEY
CLAIM OF BENEFICIAL USE
SEC 9 RESERVOIR

For

Bureau of Land Management

November 2, 2016

Prepared by

Cornerstone Surveying, Inc

P.O. BOX 33

JOHN DAY, OR. 97845

(541)575-1813

cornerstonesurvey@centurytel.net

LEGEND

Application No. R-48771

Permit No. R-7907

Priority 10/8/1971

A portion of Tax Lot
19-35 TL100

NOTE: Tax Lot 100 is owned by the BLM
and is more that 6800 acres.
Therefore only a portion of the tax
lot boundary can be shown.

NOTE: The preparation of this map
was for the purpose of identifying
the location of the proposed water
right and has no intent to provide
dimensions or location of property
ownership lines.

