


T21S, R36E, W.M.
Harney County, Oregon

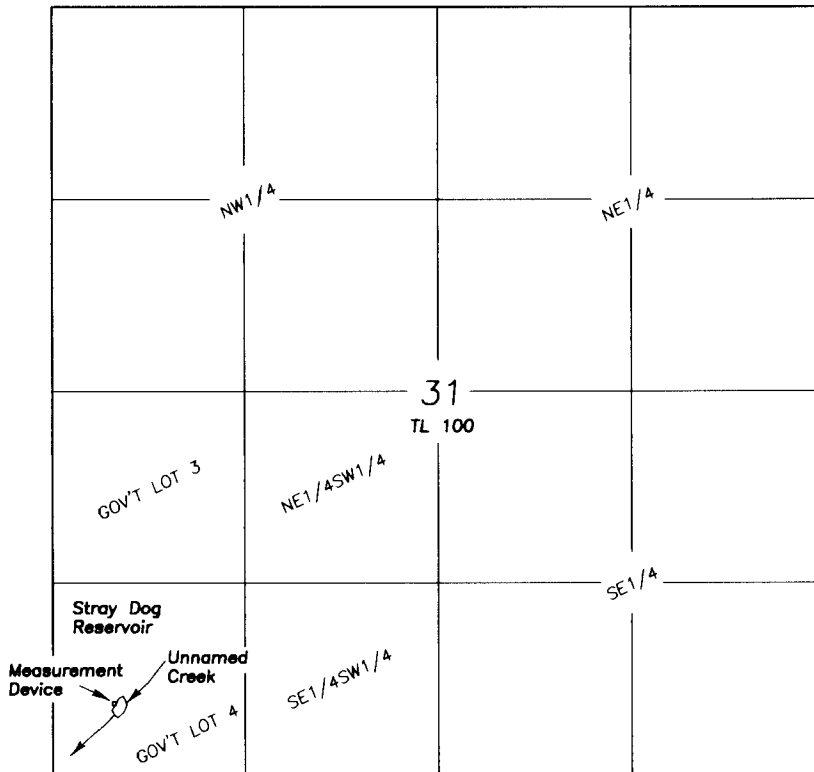

SCALE 1"=1320'

Outlet is located 490' N & 410' E of the
~~SW~~ corner of Section 31.

Measuring device is located 3' East of the Outlet

FINAL PROOF SURVEY
CLAIM OF BENEFICIAL USE
STRAY DOG RESERVOIR

For

Bureau of Land Management

November 4, 2016

LEGEND

Application No. R-45424
Permit No. R-7886
Priority 9/25/1968

A portion of Tax Lot
21-36 TL100

NOTE: Tax Lot 100 is owned by the BLM
and is more that 18,000 acres.
No tax lot boundaries can be shown.

Prepared by
Cornerstone Surveying, Inc

P.O. BOX 33
JOHN DAY, OR. 97845
(541)575-1813


cornerstonesurvey@centurytel.net

NOTE: The preparation of this map
was for the purpose of identifying
the location of the proposed water
right and has no intent to provide
dimensions or location of property
ownership lines.

RECEIVED BY OWRD

NOV 13 2016

STAGM, CE

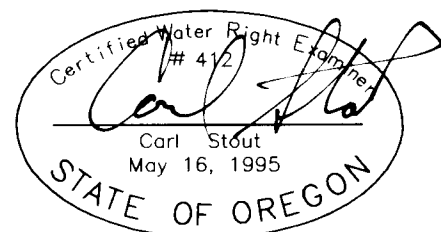

* Map revised by OWRD to correctly show the measured distance from correct corner.
JTS/wrd 12-6-16