


T22S, R34E, W.M.
Harney County, Oregon

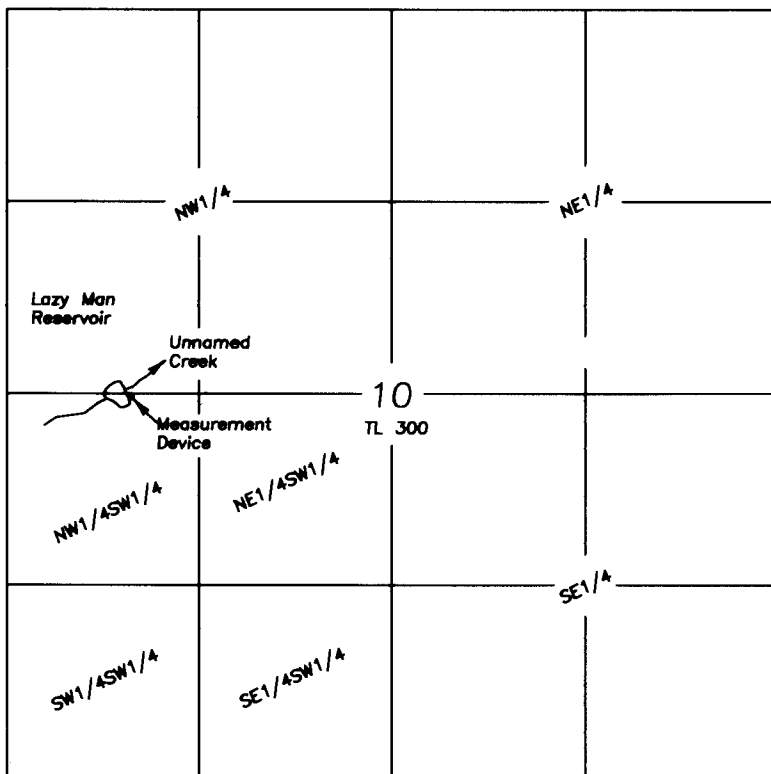

SCALE 1"=1320'

Outlet is located 2550' N & 820' E of the
SW corner of Section 10.

Measuring device is located 47' N & 37' E of the Outlet

FINAL PROOF SURVEY
CLAIM OF BENEFICIAL USE
LAZY MAN RESERVOIR

LEGEND

Application No. R-47281
Permit No. R-7903
Priority 7/24/1970

A portion of Tax Lot
22-34 TL 300

NOTE: Tax Lot 100 is owned by the BLM
and is more that 19,000 acres.
No tax lot boundaries can be shown.

For

Bureau of Land Managment
September 15, 2016

Prepared by

Cornerstone Surveying, Inc

P.O. BOX 33

JOHN DAY, OR. 97845

(541)575-1813

cornerstonesurvey@centurytel.net

RECEIVED BY OWRD

NOV 14 2016

SALEM, OR

NOTE: The preparation of this map
was for the purpose of identifying
the location of the proposed water
right and has no intent to provide
dimensions or location of property
ownership lines.

