


FINAL PROOF MAP

TO ADD POINTS OF APPROPRIATION & PLACE OF USE FOR APPLICATION G-6692

MICHAEL BUCK, KENT SCOTT, AND DARLA SCOTT

TOWNSHIP 23 SOUTH, RANGE 32 EAST, SECTION 13, W.M.
TAX LOTS: 101, 200, 300, & 400

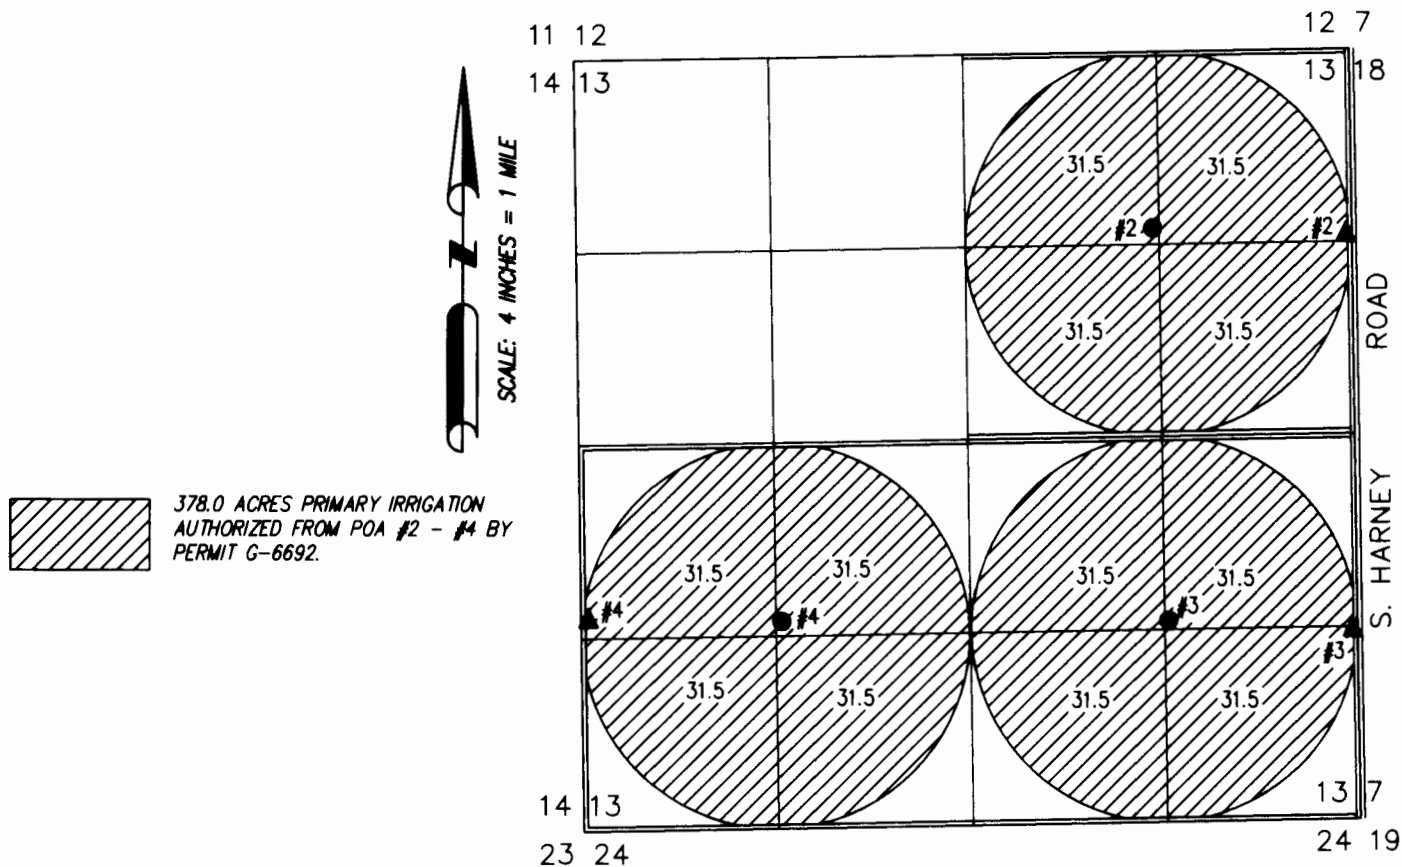

- **#2 (HARN 563)**
LOCATED IN THE NW 1/4 NE 1/4 SECTION 13, T23S R32E, W.M. AND 110 FEET NORTH AND 30 FEET WEST FROM THE NE 1/16 CORNER OF SECTION.
- ▲ **ELECTRIC METER IS 50' NORTH AND 30' WEST OF THE E 1/4 CORNER OF SECTION.**
- **#3 (HARN 562)**
LOCATED IN THE NE 1/4 SE 1/4 SECTION 13, T23S R32E, W.M. AND 60 FEET NORTH AND 30 FEET EAST FROM THE SE 1/16 CORNER OF SAID SECTION.
- ▲ **ELECTRIC METER IS 20' SOUTH AND 30' WEST OF S 1/16 CORNER BETWEEN SECTIONS 13 AND 7.**
- **#4 (HARN 561)**
LOCATED IN THE SE 1/4 SW 1/4 SECTION 13, T23S R32E, W.M. AND 100 FEET NORTH AND 40 FEET EAST FROM THE SW 1/16 CORNER OF SAID SECTION.
- ▲ **ELECTRIC METER IS 130' NORTH AND 45 FEET EAST FROM S 1/16 CORNER BETWEEN SECTIONS 13 AND 14.**



RENEWAL DATE: 12/31/2016

THIS MAP IS FOR THE PURPOSE OF
LOCATING A WATER RIGHT ONLY AND HAS
NO INTENT TO PROVIDE LEGAL DIMENSIONS
OR THE LOCATION OF PROPERTY LINES.

PREPARED FOR:

KENT & DARLA SCOTT
70014 S. HARNEY ROAD
BURNS, OR 97720

PREPARED BY:



ALL POINTS ENGINEERING AND SURVEYING, INC.
P.O. BOX 767
(541) 548-5833
TERREBONNE, OR 97760
www.APEandS.com