

FINAL PROOF MAP

TO ACCOMPANY COBU REPORT FOR
SURFACE WATER PERMIT S-53873
PERNOLL RANCH, LLC

TOWNSHIP 29 SOUTH RANGE 17 EAST, W.M.
SECTIONS 27 & SECTIONS 34
TAX LOT 1700
LAKE COUNTY, OREGON

RECEIVED BY OWRD

JUL 13 2012

SALEM, OR



69.5 IRRIGATION ACRES FROM
S-53873, AS SHOWN.

▲ **POD #1 (S-53873)**

LOCATED IN THE SW 1/4 SW 1/4 SECTION
27 AND 1115' NORTH AND 1350' WEST FROM
THE S 1/4 CORNER THEREOF

▲ **POD #2 (S-53047)**

LOCATED IN THE SW 1/4 NE 1/4 SECTION 34
AND 334' NORTH AND 1642' WEST FROM THE
E 1/4 CORNER THEREOF




RENEWAL DATE: 12/31/2012

THIS MAP IS FOR THE PURPOSE OF LOCATING A WATER
RIGHT ONLY AND HAS NO INTENT TO PROVIDE LEGAL
DIMENSIONS OR THE LOCATION OF PROPERTY LINES



SCALE: 4 INCHES = 1 MILE

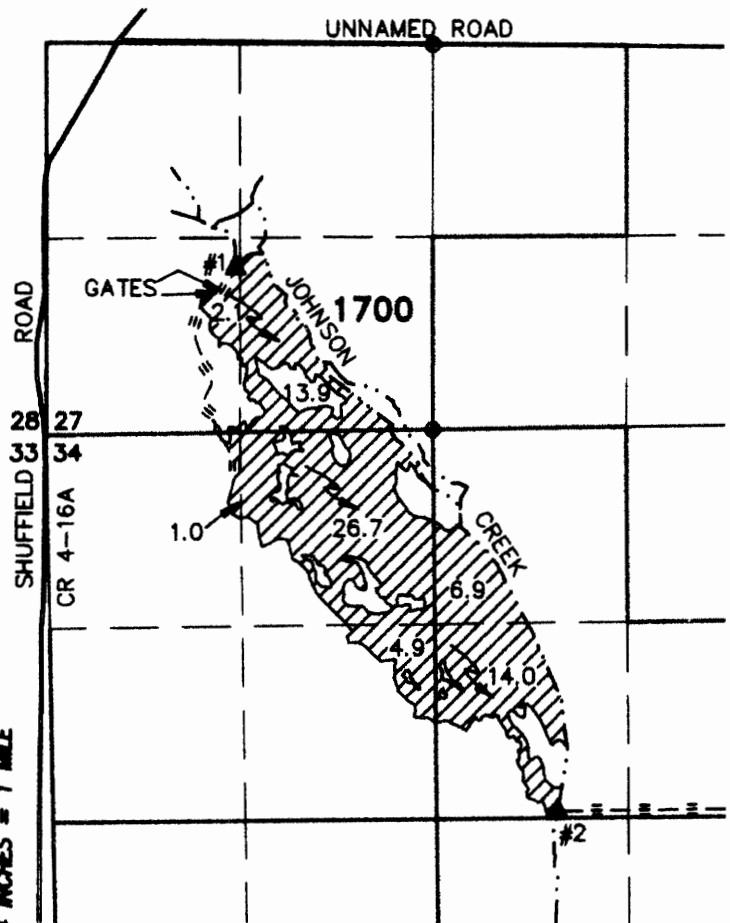

◆ GOVERNMENT CORNER MONUMENT

---==---==---==---
SUPPLY CANAL

PREPARED FOR:

PERNOLL RANCH, LLC
705 GREENSBURG CIRCLE
RENO, NV 89509

PREPARED BY:



ALL POINTS ENGINEERING AND SURVEYING, INC.
P.O. BOX 767 (CRR) TERREBONNE, OR 97760
(541) 548-5833 www.APEandS.com