
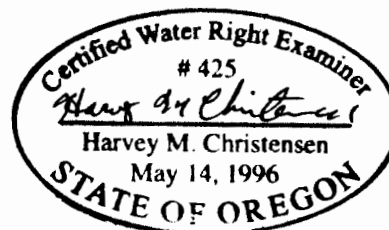


**WATER RIGHT CLAIM OF BENEFICIAL USE  
FOR: DONOVAN JONES  
LOCATED IN  
NE1/4 OF THE SE1/4, SECTION 30, T15S, R5W, W.M.  
TAX LOT # 15 05 30 700  
LANE COUNTY, OREGON  
NOVEMBER 10, 2010**

**APP. # R-84384, PERMIT # R-12995  
APP. # S-84385, PERMIT # S-53726**

DEC 30 2010

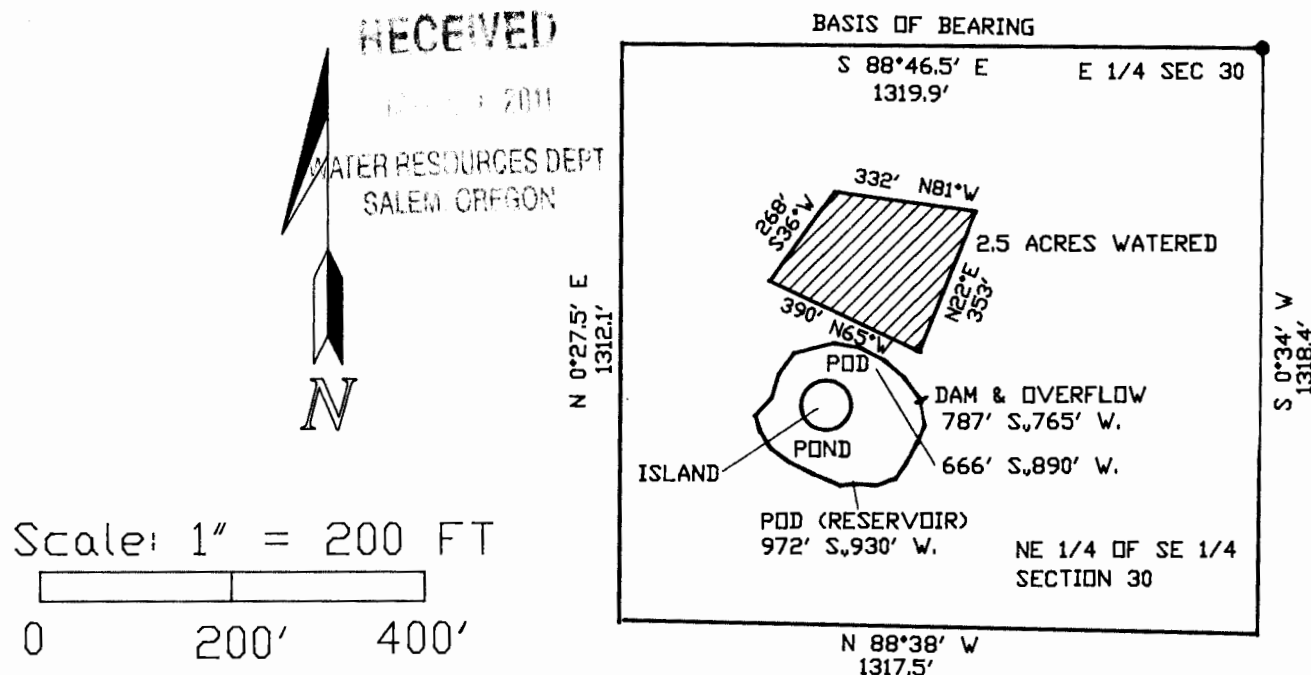

LICENSE RENEWAL DATE DECEMBER 31, 2012

**NORTHWEST TIMBERLAND CONSULTING, INC.  
37036 HWY #58, PLEASANT HILL, OR. 97455-9785  
PHONE OR FAX (541) 461-4076**

**MAP # 15-05-30-000700**