

IRINA AND JAMES P JUST
APPLICATION NO. R-80525
PERMIT NO. R-12241



CLAIM OF BENEFICIAL USE MAP

SECTION 16, TOWNSHIP 11 SOUTH, RANGE 1 WEST, WM
LINN COUNTY, OREGON



BASED ON OCRS
SALEM ZONE

SCALE 1" = 400'

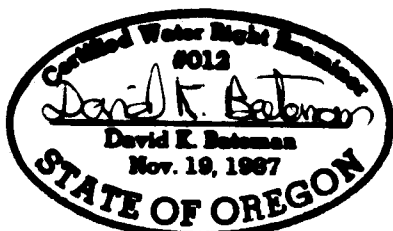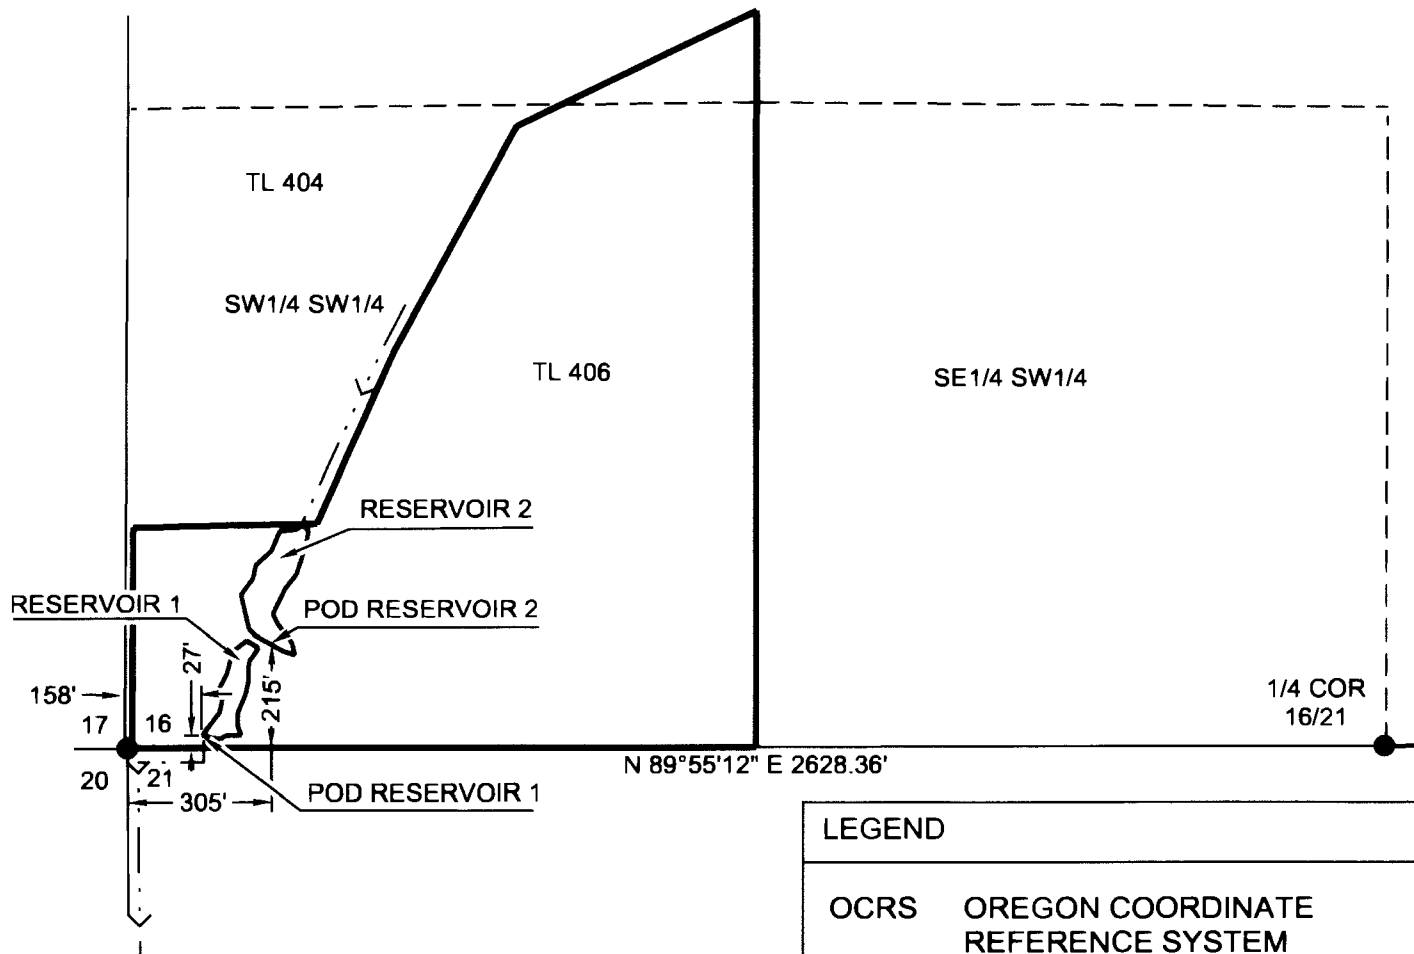

Expires 12-31-13

BATEMAN CONSULTING
42755 FISH HATCHERY DRIVE
SCIO, OREGON 97374
503-394-2051

This map was prepared for the purpose of identifying the location of a water right only and is not intended to provide legal dimension or location of property ownership lines.

LEGEND

- | | |
|---------------|---------------------------------------|
| OCRS | OREGON COORDINATE
REFERENCE SYSTEM |
| ● | FOUND SURVEY MONUMENT |
| — | PERMIT HOLDER
PROPERTY LINE |
| - - - > - - - | PONDEROSA CREEK |