




Property Description

The North Half of the Northeast Quarter of Section 24, Township 35 South,
Range 1 West of the Willamette Meridian Tax Lot 100, Jackson County,
Oregon

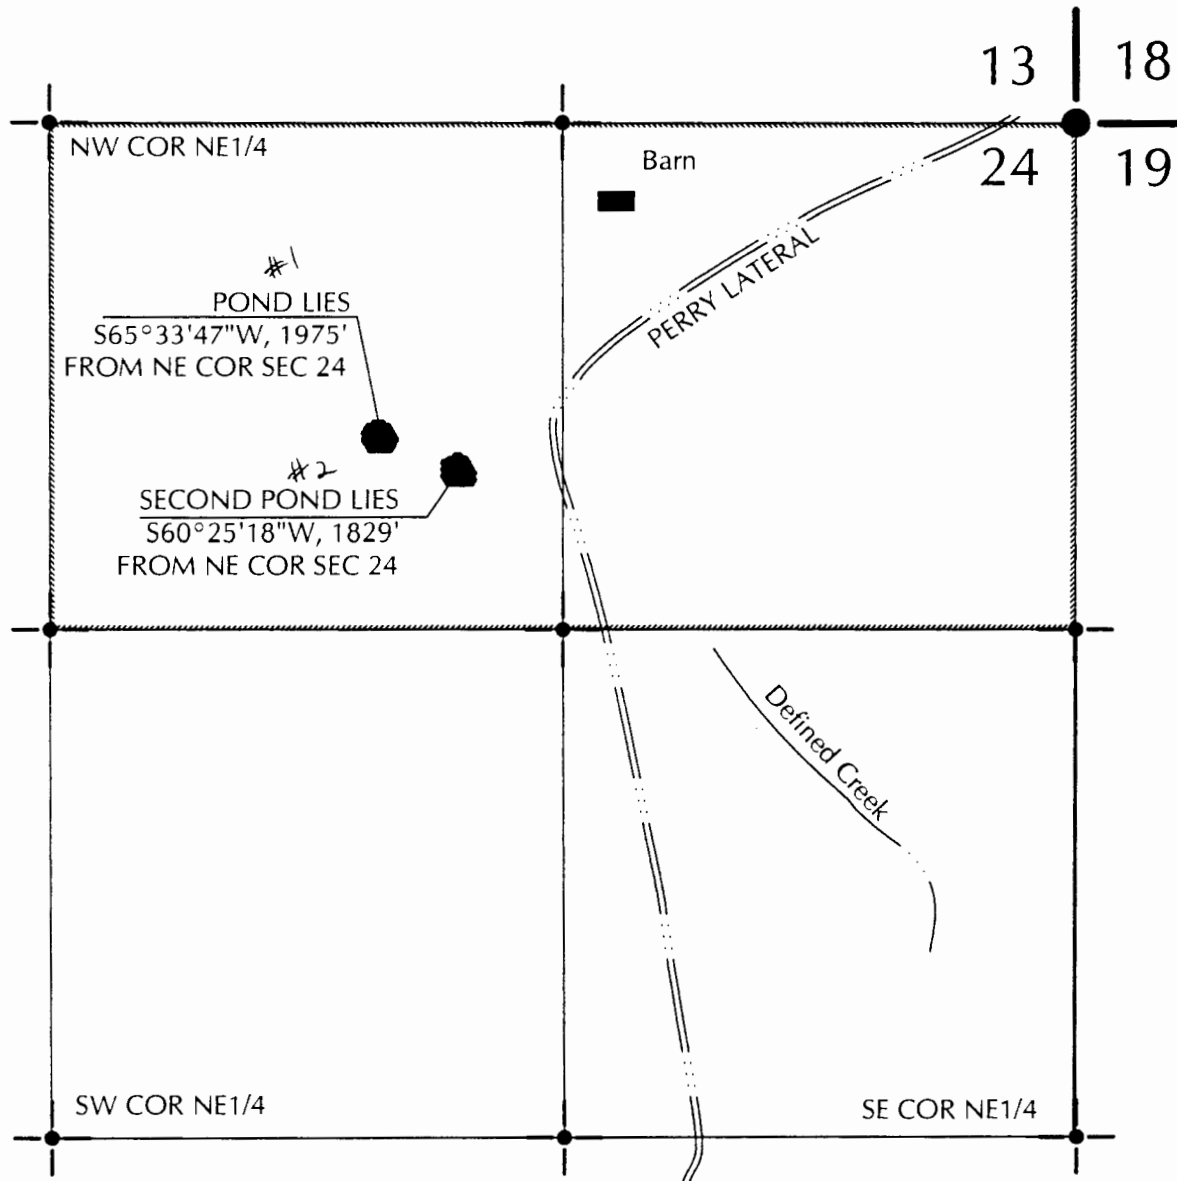

SCALE: 1"=500'

RECEIVED

DEC 11 2006

WATER RESOURCES DEPT
SALEM, OREGON

RECEIVED

NOV 20 2006

WATER RESOURCES DEPT
SALEM, OREGON

PX Public Works
Management, Inc.

3572 N. FOOTHILL ROAD, MEDFORD, OR 97504
(541) 776-7855

JOE STRAHL, P.E. AND C.W.R.E. (541) 301-2946
JEFF BALLARD, EIT. (541) 301-1555
TONY BAKKE, P.E. (541) 324-6055

DRAWN BY: JAB

DATE: October 09, 2006

2403 BROPHY ROAD
EAGLE POINT, OREGON

WATER STORAGE PERMIT

