


Richard D Stephens COBU Map

App.- R-86571, Permit-R-14329





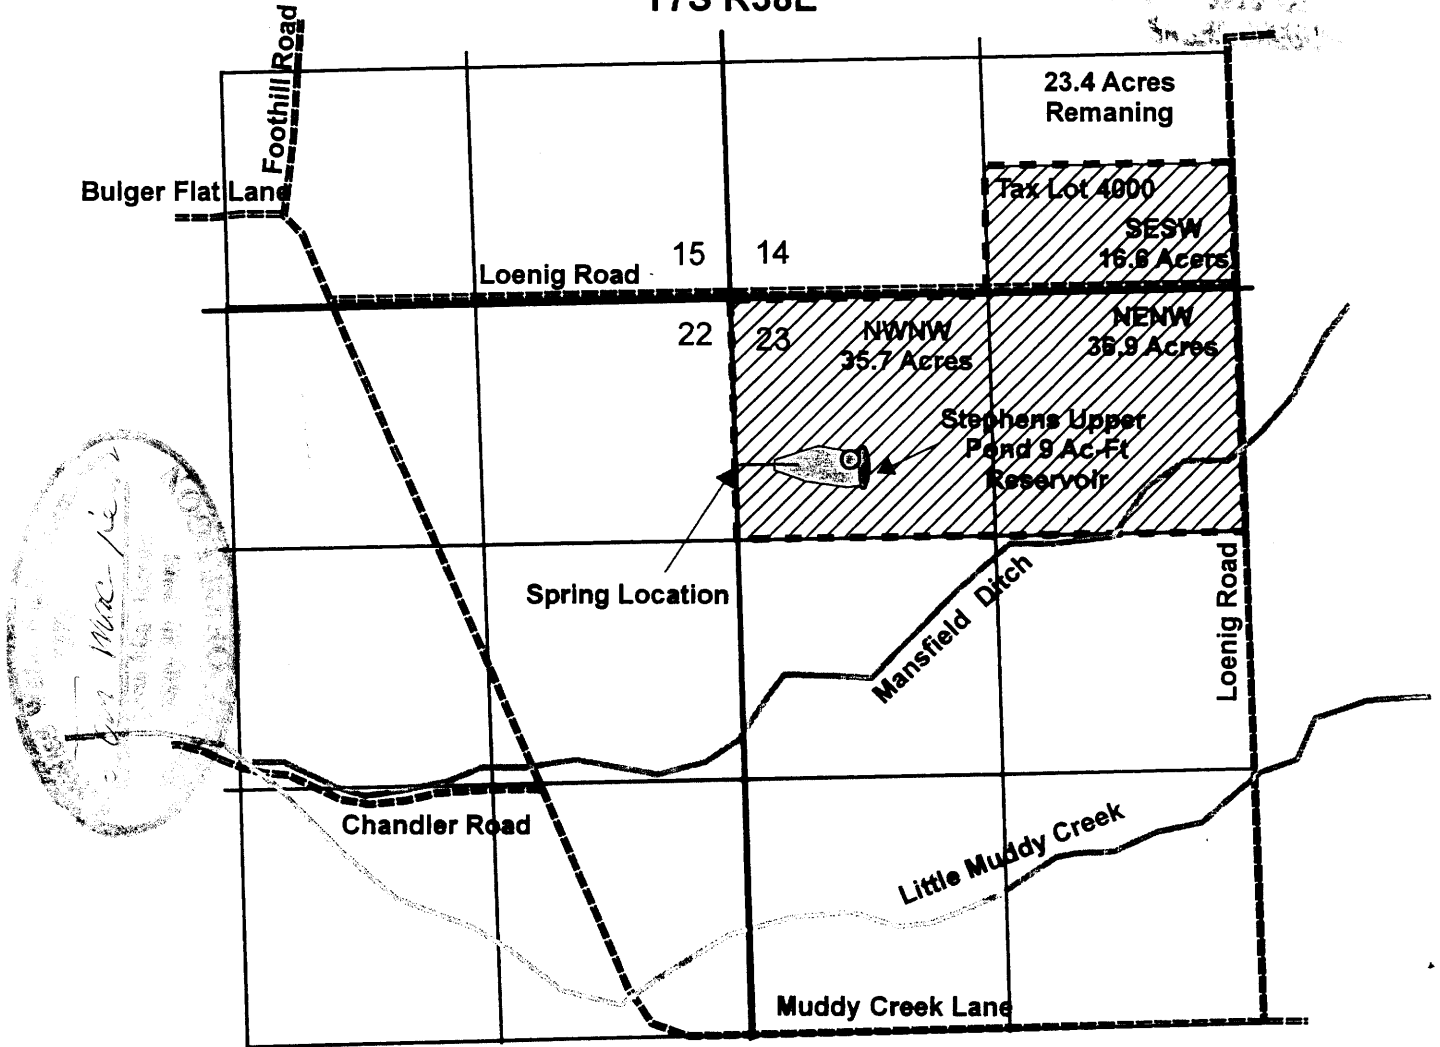



T7S R38E



POU: 89.2 acres in Tax Lot 4000 -T7S, R38E, Sec 14, 23
 POA: A Spring located 900' South from NE Corner, Section 23
 Dam Location: 910' South and 650' East from NW Corner, Section 23
 Measuring Device Stephens Upper Pond: 890' South and 580' East from NW Corner, Section 23

LEGEND

-  Irrigated acres
-  Creek/ Ditch
-  Roads
-  Pipeline
-  Taxlot Boundary
-  Measuring Devices

DISCLAIMER

This map is not intended to provide legal dimensions or locations of property ownership lines