
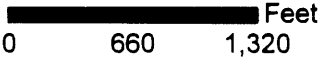


Richard D. Stephens COBU Map

App. S-86572, Permit S-54368

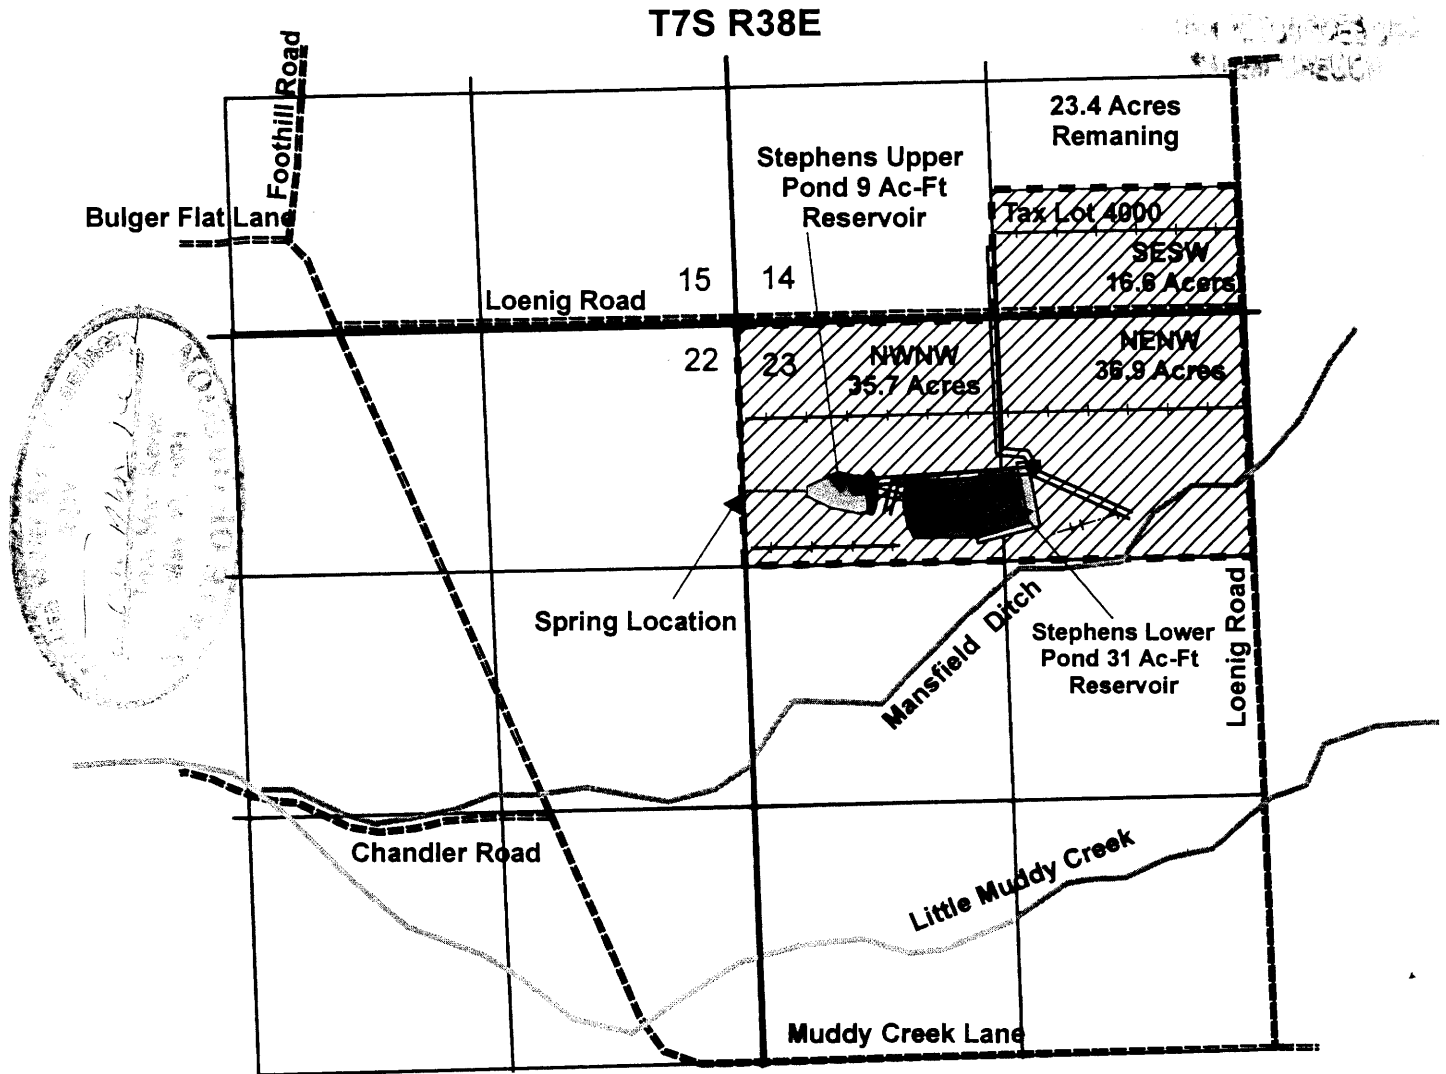

POU: 89.2 acres in Tax Lot 4000 -T7S, R38E, Sec 14, 23
 POA: A Spring located 900' South from NE Corner, Section 23
 POD: Stephens Upper Pond located 910' South and 650' East from NW Corner, Section 23
 Dam Location: 1000' South and 1520' East from NW Corner, Section 23
 Measuring Device Stephens Upper Pond: 890' South and 580' East from NW Corner, Section 23
 Measuring Device Stephens Lower Pond: 890' South and 1430' East from NW Corner, Section 23

LEGEND

- Irrigated acres
- Creek/ Ditch
- Roads
- Pipeline
- Taxlot Boundary
- Measuring Devices
- Pump Station
- Wheel Lines
- Hand Lines

DISCLAIMER
 This map is not intended to provide legal dimensions or locations of property ownership lines