


Richard D. Stephens COBU Map

App.- R-87407, Permit-R-14761

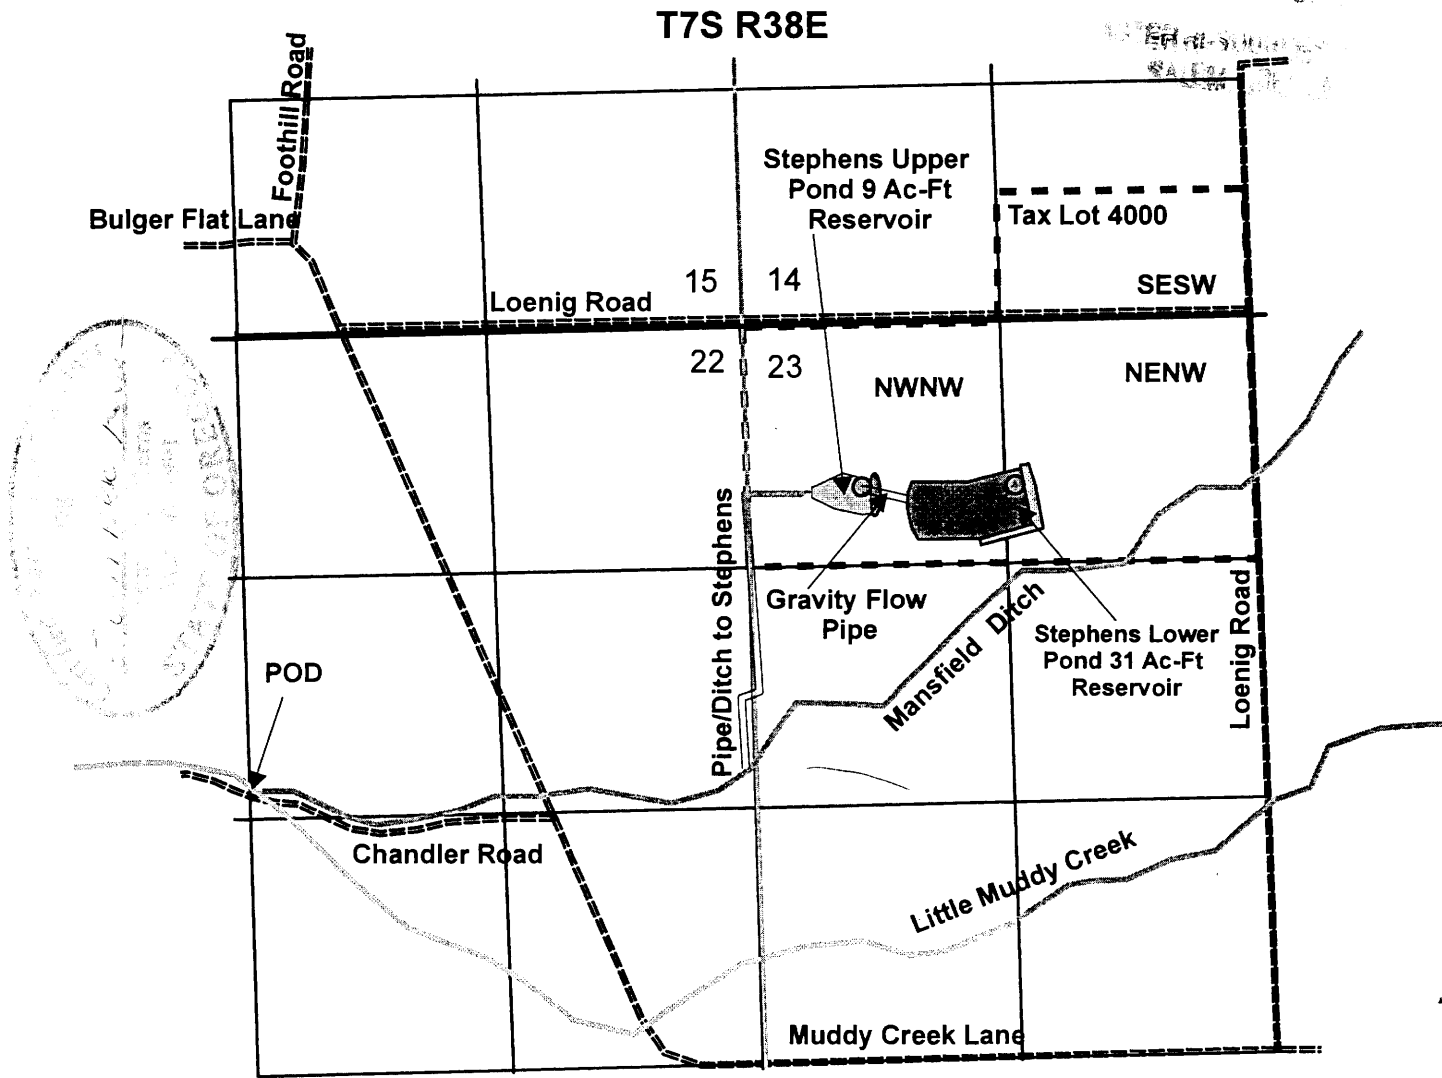

POU: 89.2 acres in Tax Lot 4000 -T7S, R38E, Sec 14, 23

POD: Mansfield Ditch POD on Little Muddy Creek is 2470' South and 2540' West from NE Corner, Section 22

POD: Stephens Upper Pond located 910' South and 650' East from NW Corner, Section 23

Dam Location: 1000' South and 1520' East from NW Corner, Section 23

Measuring Device Stephens Upper Pond: 890' South and 580' East from NW Corner, Section 23

Measuring Device Stephens Lower Pond: 890' South and 1430' East from NW Corner, Section 23

LEGEND

- Creek/ Ditch
- Roads
- Pipeline
- Taxlot Boundary
- Measuring Devices

DISCLAIMER

This map is not intended to provide legal dimensions or locations of property ownership lines