


# Richard D. Stephens COBU Map

## App.- R-86570, Permit-R-14328

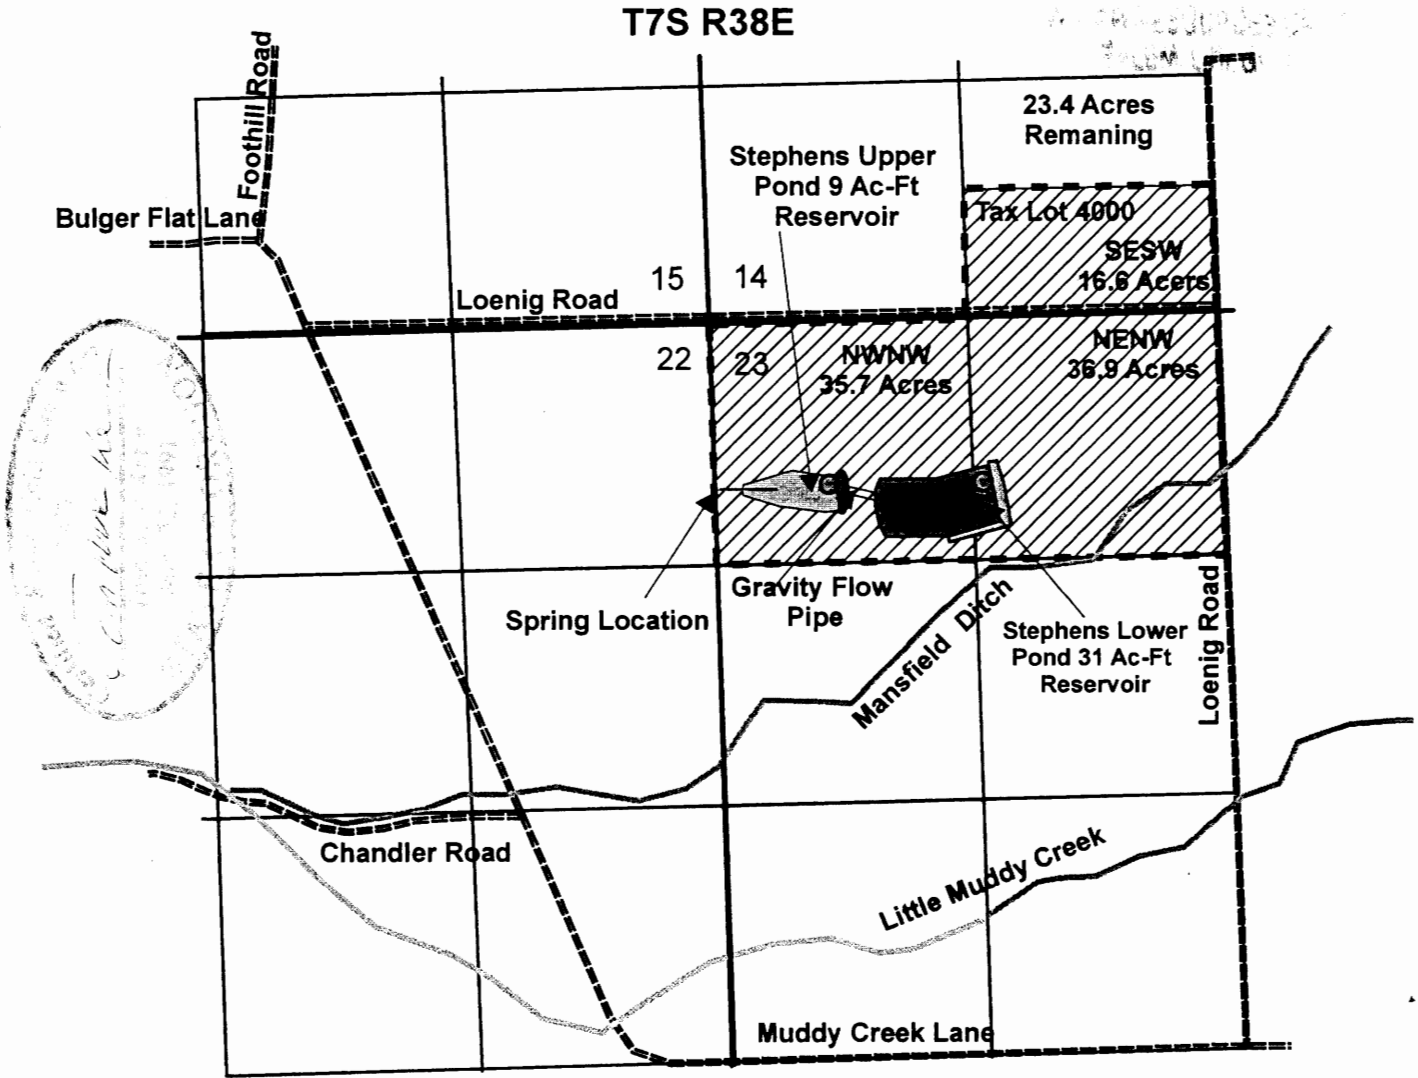

**POU:** 89.2 acres in Tax Lot 4000 -T7S, R38E, Sec 14, 23


**POA:** A Spring located 900' South from NE Corner, Section 23

**POD:** Stephens Upper Pond located 910' South and 650' East from NW Corner, Section 23

**Dam Location:** 1000' South and 1520' East from NW Corner, Section 23

**Measuring Device Stephens Upper Pond:** 890' South and 580' East from NW Corner, Section 23

**Measuring Device Stephens Lower Pond:** 890' South and 1430' East from NW Corner, Section 23

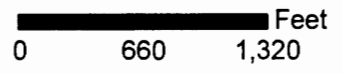

**LEGEND**

- Irrigated acres
- Creek/ Ditch
- Roads
- Pipeline
- Taxlot Boundary
- Measuring Devices

**DISCLAIMER**

This map is not intended to provide legal dimensions or locations of property ownership lines