




CLAIM OF BENEFICIAL USE (REVISED)

APPLICATION R-73607 PERMIT R-11899
APPLICATION R-73608 PERMIT R-11896
APPLICATION S-73609 PERMIT S-52556

IN THE NAME OF MARTHA MILLER

RECEIVED

TOWNSHIP 39 SOUTH, RANGE 7 WEST, W.M.
JOSEPHINE COUNTY, OREGON

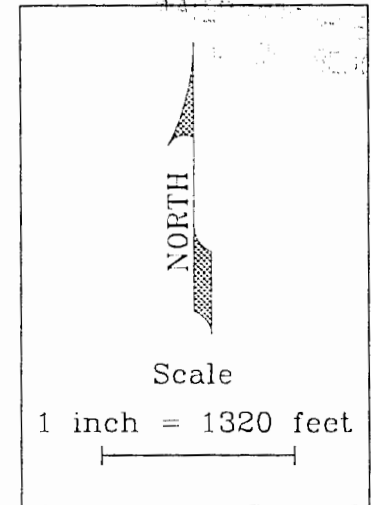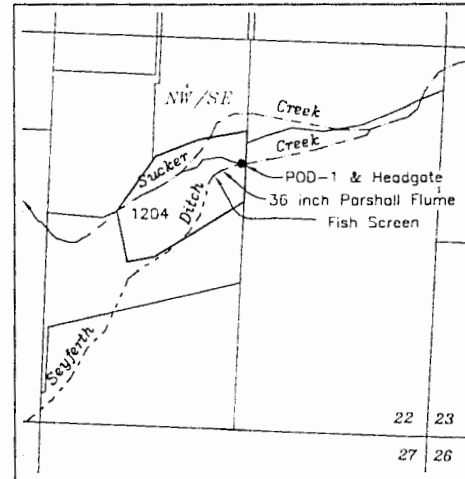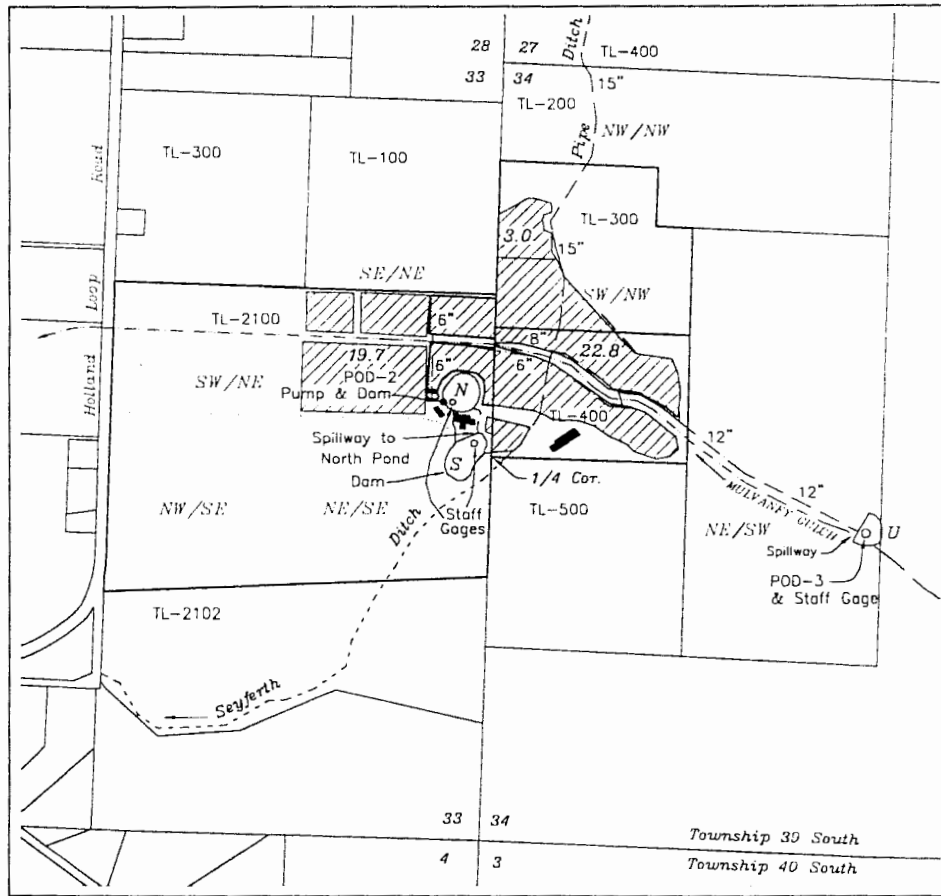

Point of diversion (POD-1) - 1820 feet north & 1330 feet west from the SE corner of section 22

Point of diversion (POD-2) - Pump & Dam 350 feet north & 330 feet west from the E 1/4 corner of section 33


Point of diversion (POD-3) - 12 inch Outlet 450 feet north & 2570 feet east from the W 1/4 corner of section 34

South Pond Spillway - 160 feet north & 90 feet west from the E 1/4 corner of section 33

South Pond Dam - 120 feet south & 310 west from the E 1/4 corner of section 33

Base map - Josephine County GIS tax lots overlaid on 2005 FSA aerial photo for assumed best fit

This map is not intended to provide legal dimensions or locations of property ownership lines

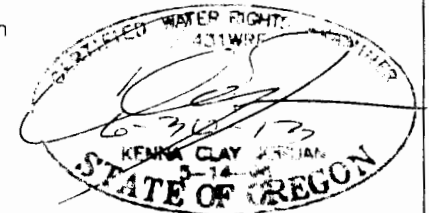

Agricultural Use / Frost Protection

N - North Pond 5.0 A.F. } Aesthetics, Frost Control
S - South Pond 6.5 A.F. }

U - Unnamed Res 7.0 A.F. - Agricultural Use (Frost Protection)

----- Ditch

----- Pipeline

----- Driveway

WRD revised map to reflect 450' SOUTH, for POD 3. mb/wrd 12-6-16

JORDAN ENGINEERING
460 JORDAN LANE
ROSEBURG, OR 97471
(541) 673-1931

Revision-2 9/20/2011 n.e.d.