

SCALE: 1"=1320'

RECEIVED BY OWRD

AUG 08 2012

SALEM, OR

****NOTES****

Pump Site with flowmeter is located 1260' South and 85' East of the West 1/4 corner of Section 15.

Center of Pond is located 1240' South and 60' East of the West 1/4 corner of Section 15.

Existing P.O.D. #1 Permit number 30977 is located 700' South of West 1/4 corner of Section 15.

Existing P.O.D. #2 Permit number 30977 is located 1350' South of West 1/4 corner of Section 15.

Existing Fish Screen is located 15' North and 10 ft. East of POD #2.

LEGEND

- Existing Survey Monument
- Existing irrigation ditch or creek


August 2, 2012

**FINAL PROOF MAP TO
STORE WATER IN A POND
FOR
MIKE & TRACY PARTNEY**

BAGETT-GRIFFITH & BLACKMAN
2006 ADAMS AVENUE
LA GRANDE, OREGON 97850

APPLICATION NO. R-86842

PERMIT NUMBER R-14459

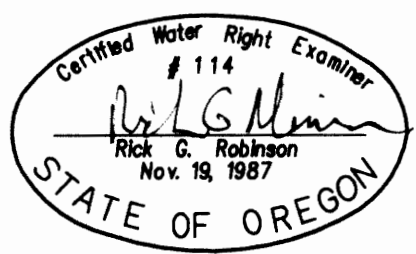

NOTE: The preparation of this map is for the purpose of identifying the location of the proposed water right and has no intent to provide dimensions or location of property ownership lines.