


0621

11

ALUMINUM CAP SET FOR
1/4 CORNER IN CSF 27857

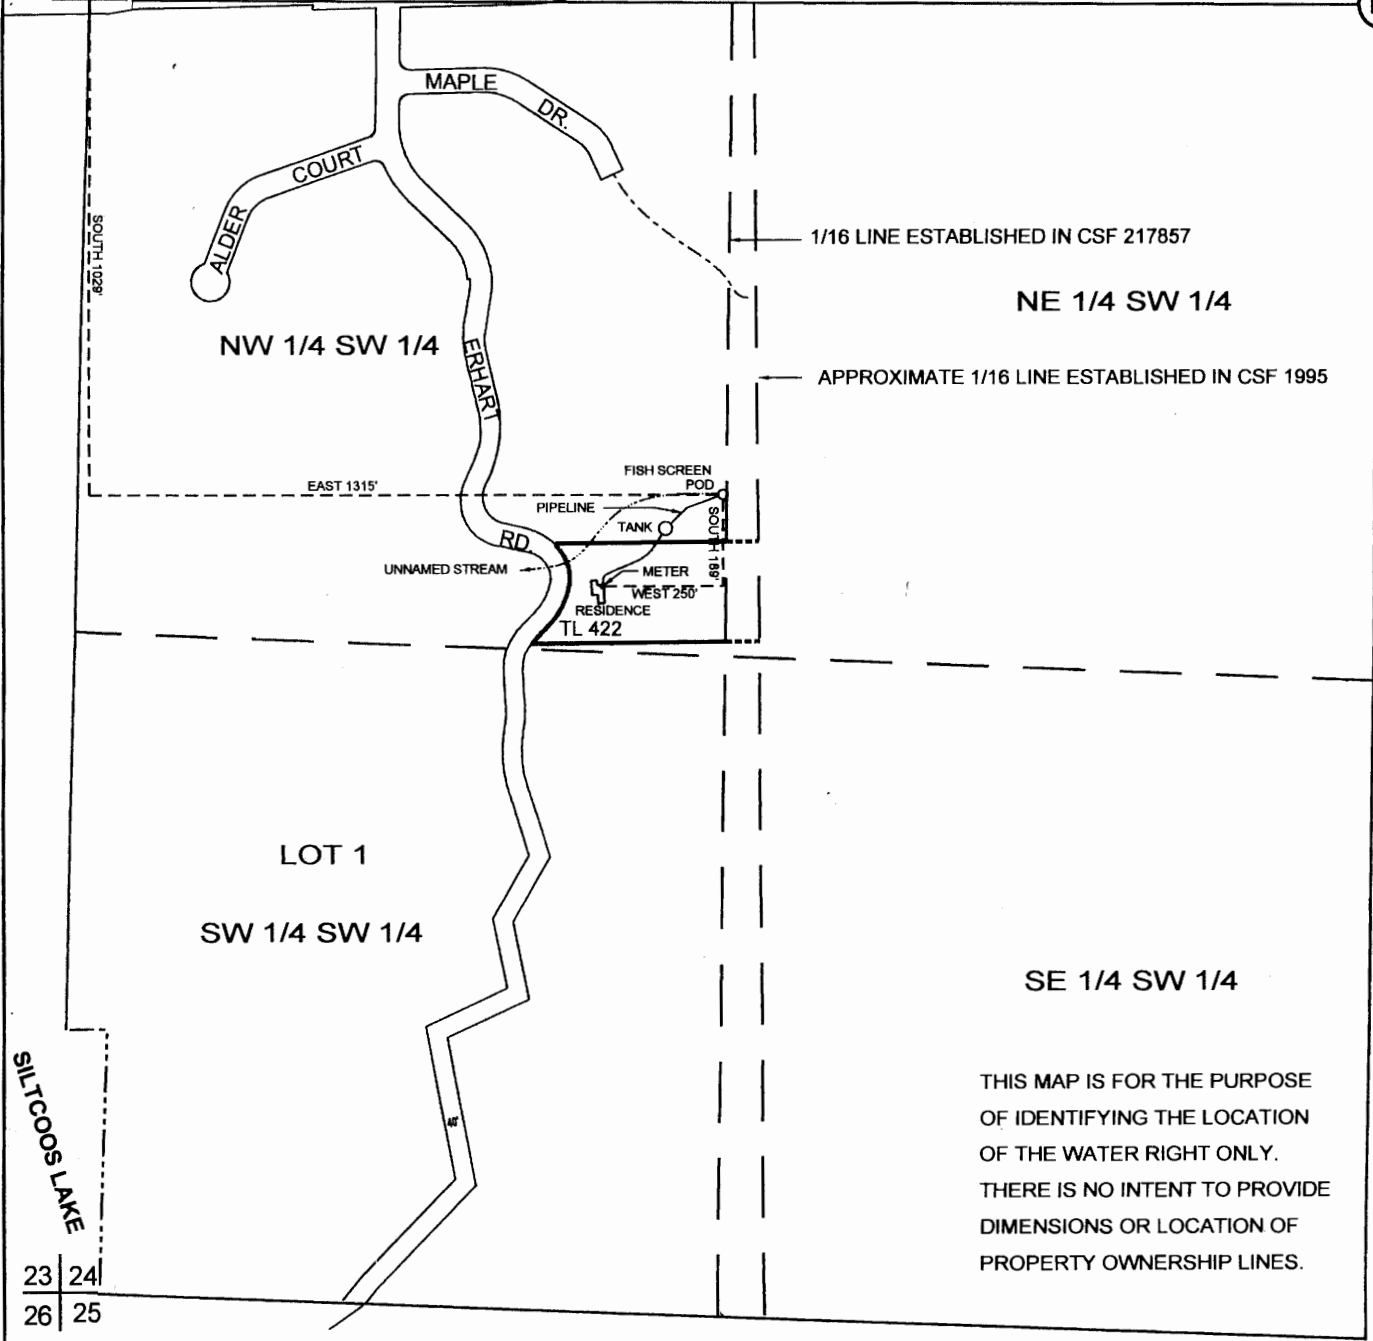

THIS MAP IS FOR THE PURPOSE
OF IDENTIFYING THE LOCATION
OF THE WATER RIGHT ONLY.
THERE IS NO INTENT TO PROVIDE
DIMENSIONS OR LOCATION OF
PROPERTY OWNERSHIP LINES.

RECEIVED

SEP 25 2011

WATER RESOURCES DEPT
SALEM, OREGON

FINAL PROOF SURVEY CLAIM OF BENEFICIAL USE WATER RIGHTS MAP

MID COAST BASIN
UNDER

PERMIT 54232

APPLICATION NO S-86345

NW 1/4 SW 1/4, SEC. 24, T19S, R12W, W.M.

19-12-24, TL 422

LANE COUNTY, OREGON

CORRU MAP #