

CLAIM OF BENEFICIAL USE
LOCATED IN THE NW¼ OF THE NW¼ OF SEC. 26,
T.21S., R.12W., W.M., DOUGLAS COUNTY, OREGON

PREPARED FOR: ROME CREEK TIMBER, LLC

APPLICATION: R-75652

PERMIT: R-11817

PREPARED BY: STUNTZNER ENG. & FORESTRY,
COOS BAY, OREGON

DATE: MAR. 2012




LEGEND

- GOVT. CORNER
- ◐ POINT OF DIVERSION
- ◻ EXIST. STEP BLDGS.

NOTE: THE POINT OF
DIVERSION IS LOCATED 784
FEET SOUTH AND 2583 FEET
WEST FROM THE ¼ CORNER
BETWEEN SEC. 23 AND 26.

HWY. 101

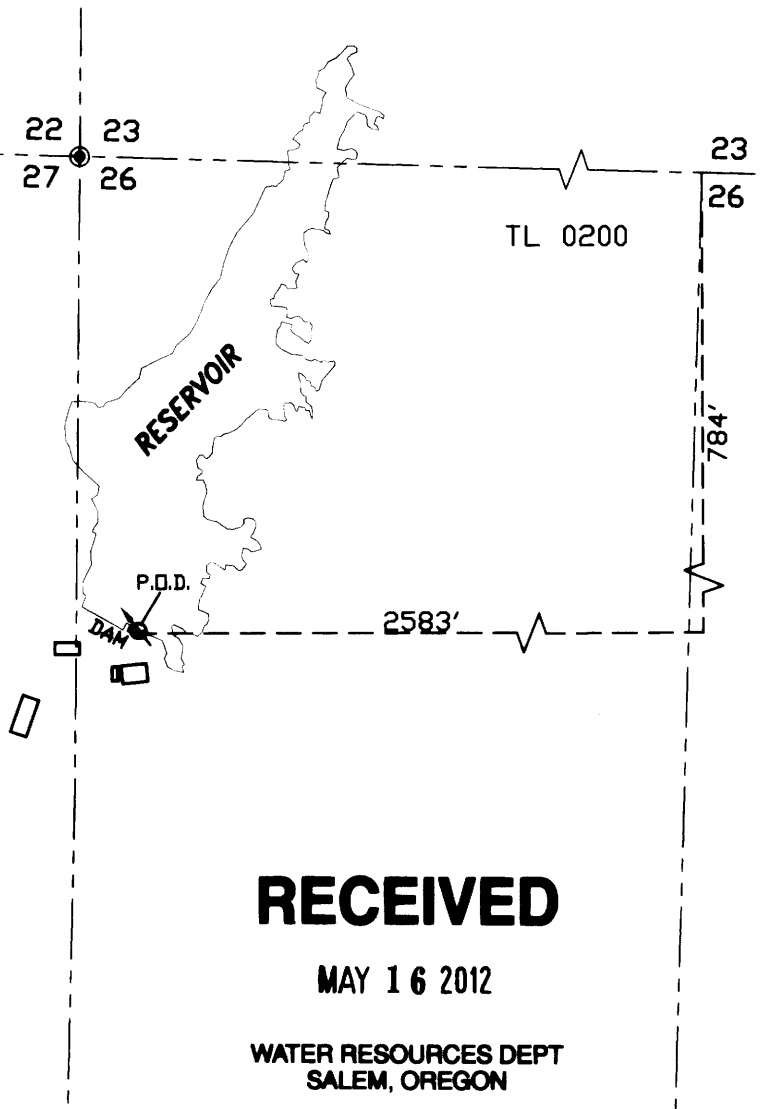

RECEIVED

MAY 16 2012

WATER RESOURCES DEPT
SALEM, OREGON

SCALE 1" = 400 Ft.



EXPIRES 12/31/2012

THE PREPARATION OF THIS MAP WAS FOR THE
PURPOSE OF IDENTIFYING THE LOCATION OF
THE WATER RIGHT ONLY AND HAS NO INTENT
TO PROVIDE DIMENSIONS OR LOCATION OF
PROPERTY OWNERSHIP.

Stuntzner
Engineering
& Forestry, LLC

705 S. 4TH ST.
P.O. BOX 118
COOS BAY, OREGON 97420

PHONE: (541) 267-2872
FAX: (541) 267-0588
www.stuntzner.com

Engineering - Land Surveying - Forestry - Land Planning - Water Rights

JOB #: 12-3-034

DATE: Mar. 08, 2012

DRAWN BY: ELS

CHECKED BY: DRG/JM

PREPARED

FOR:

ROME CR. TIMBER, LLC

P.O. BOX 1088

ROSEBURG, OR 97470

FILE NAME: Survey Block Title.dwg

SHEET 1 OF 1