


T3S R3W WM

YAMHILL COUNTY

TAX LOT:
3 3W 17 1000

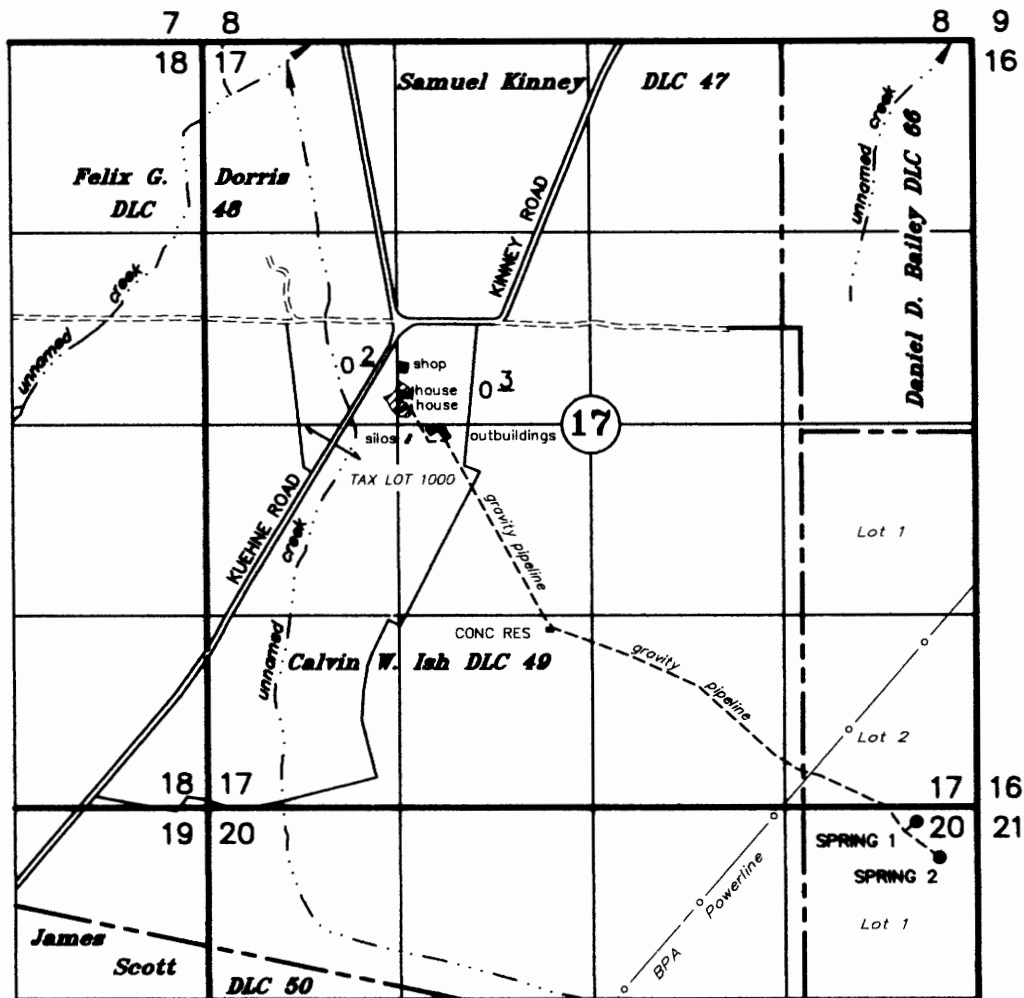

Spring 1: 100' SOUTH and 415' WEST OF SE COR SEC 17

Spring 2: 350' SOUTH and 260' WEST OF SE COR SEC 17

FINAL PROOF SURVEY

UNDER

Application No. S-80532 Permit No. S-52223


IN THE NAME OF

Harold R & Jolene Kuehne

July 6, 2011

SCALE 1" = 1320'

NOTE: This map is for the purpose of identifying the location of water rights and has not intent to dimension or locate property ownership lines.

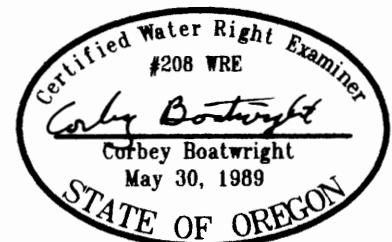

RENEWAL DATE: DECEMBER 31, 2011