


T.1N. R.17E. Section 5 W.M.

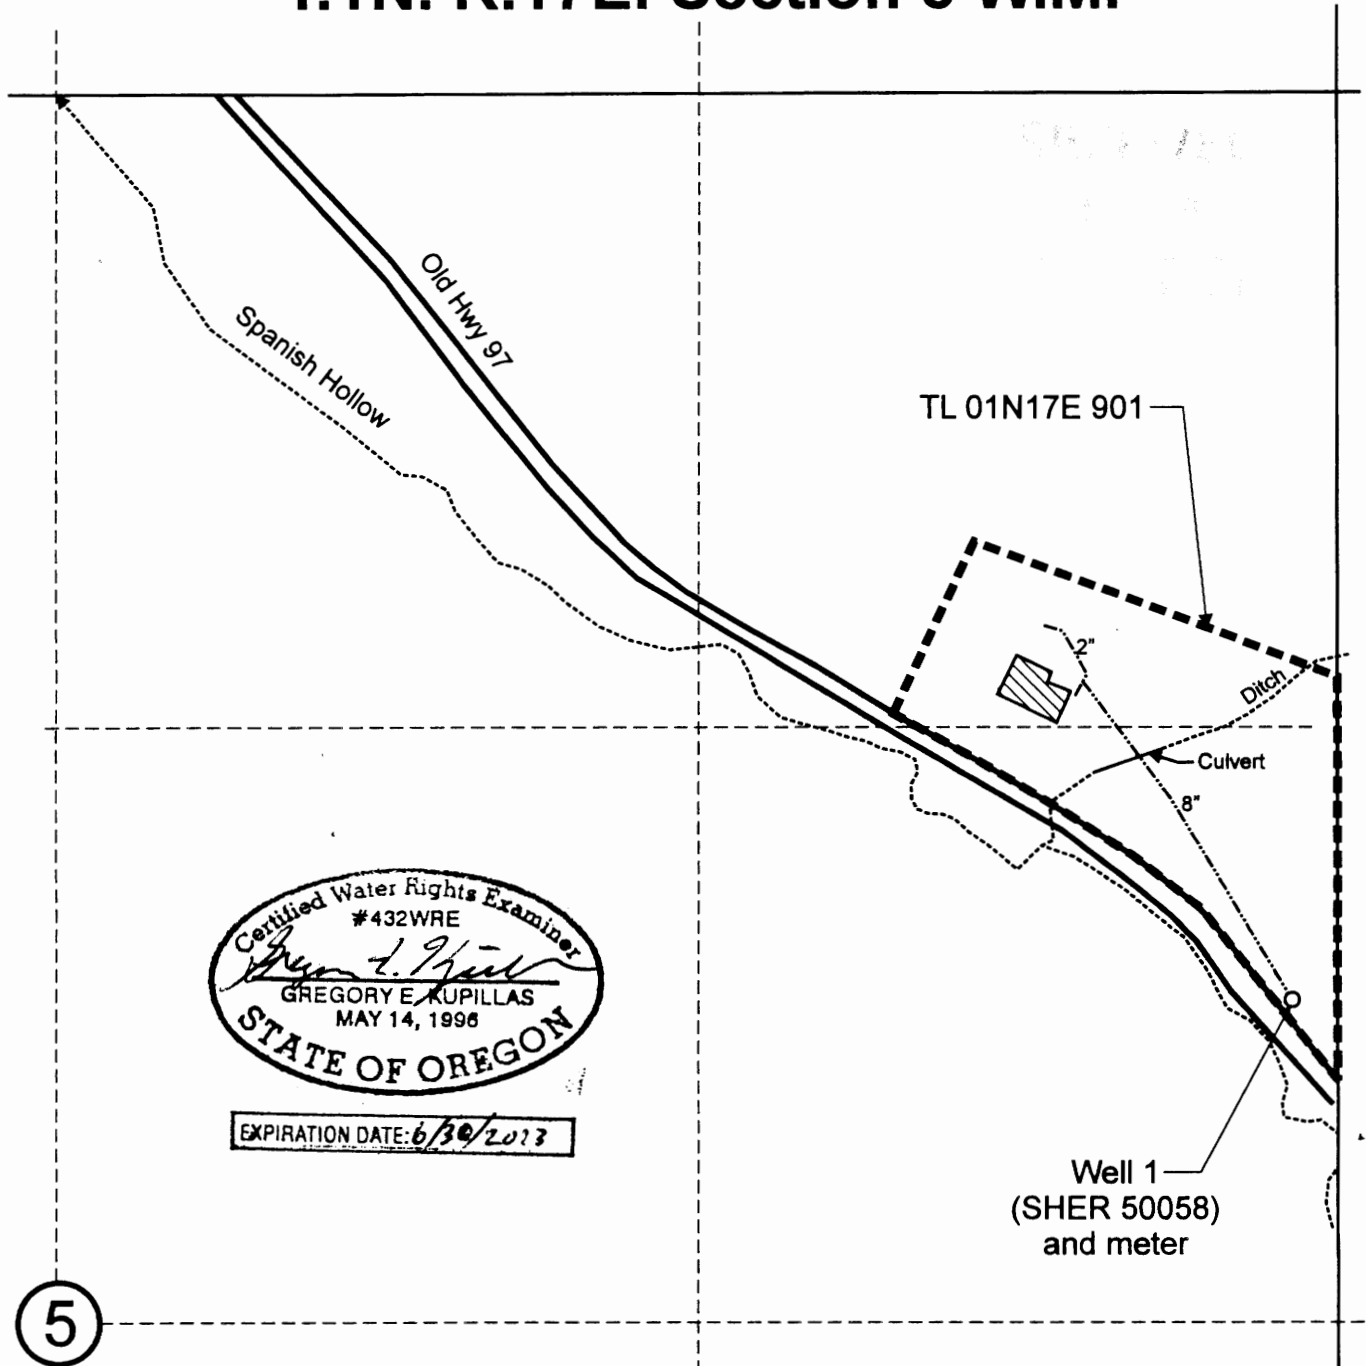


5

Well 1 (SHER 50058) is located 1,665 feet south and 95 feet west from the NE corner of Section 5.

Place of use for fire protection and commercial use under Application G-16885, Permit G-16385.

Tax lot boundary Mainline, buried

Scale: 1" = 400'

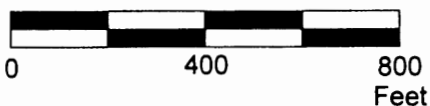

This map was prepared for the purpose of identifying the location of a water right only and is not intended to provide legal dimensions or location of property ownership lines.

Claim of Beneficial Use Map
Application G-16885, Permit G-16385

Morrow County Grain Growers
T.1N. R.17E. Section 5, W.M.

Pacific Hydro-Geology Inc.

05/2012