


T 18 S, R 5 W, Sec 6  
 pond in SE 1/4, SE 1/4, TL 101  
 scale 1" = 500'

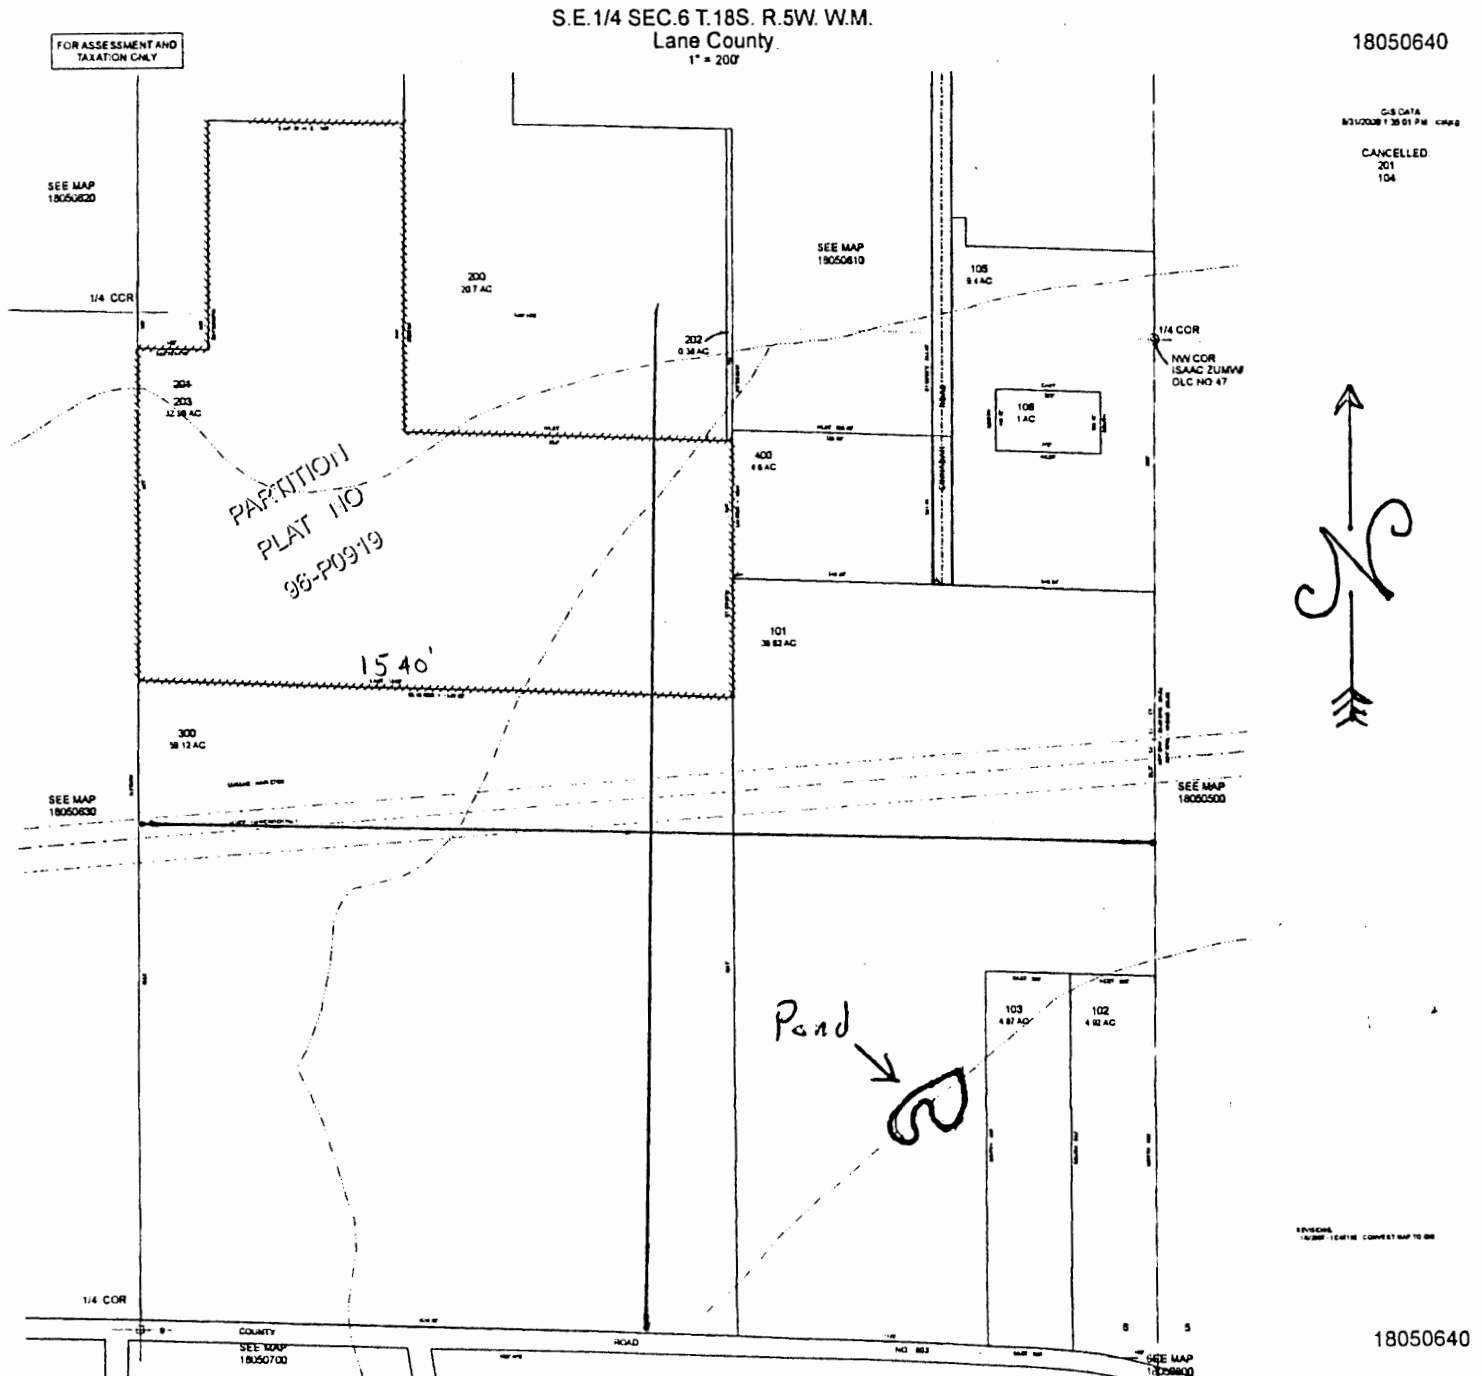

Dam is 670' N & 500' W from  
 SE cor Sec 6

RECEIVED BY OWRD  
 RECEIVED BY OWRD  
 APR 21 2017  
 SALEM, OR

OCT 30 2014  
 SALEM, OR

R-88028/R-15096