


COBU MAP 1026

CLAIM OF BENEFICIAL USE
APPLICATION S-70638 PERMIT S-53510
TOWNSHIP 29 SOUTH, RANGE 12 WEST, W.M.
COOS COUNTY OREGON

COBU Prepared For:
 Ron La Franchi
 580 N. Central
 Coquille, OR 97423

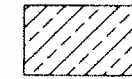

Livestock Use

● Water Tanks




Pipelines

■ Buildings

○ Points of Diversion

- 1 - SW/NE, 410 feet south & 440 feet west from the NE 1/16 Corner Section 16
- 2 - NW/NE, Lot 7, 594 feet south & 91 feet east from the N 1/4 Corner Section 21
- 3 - SW/NE, Lot 6, 1485 feet south & 1500 feet east from the N 1/4 Corner Section 21
- 7 - NW/NE, 349 feet south & 423 feet east from the N 1/4 Corner Section 23
- 8 - NW/NE, 770 feet south & 230 feet east from the N 1/4 Corner Section 23
- 9 - NW/SW, 321 feet south & 890 feet west from the CW 1/16 Corner Section 14


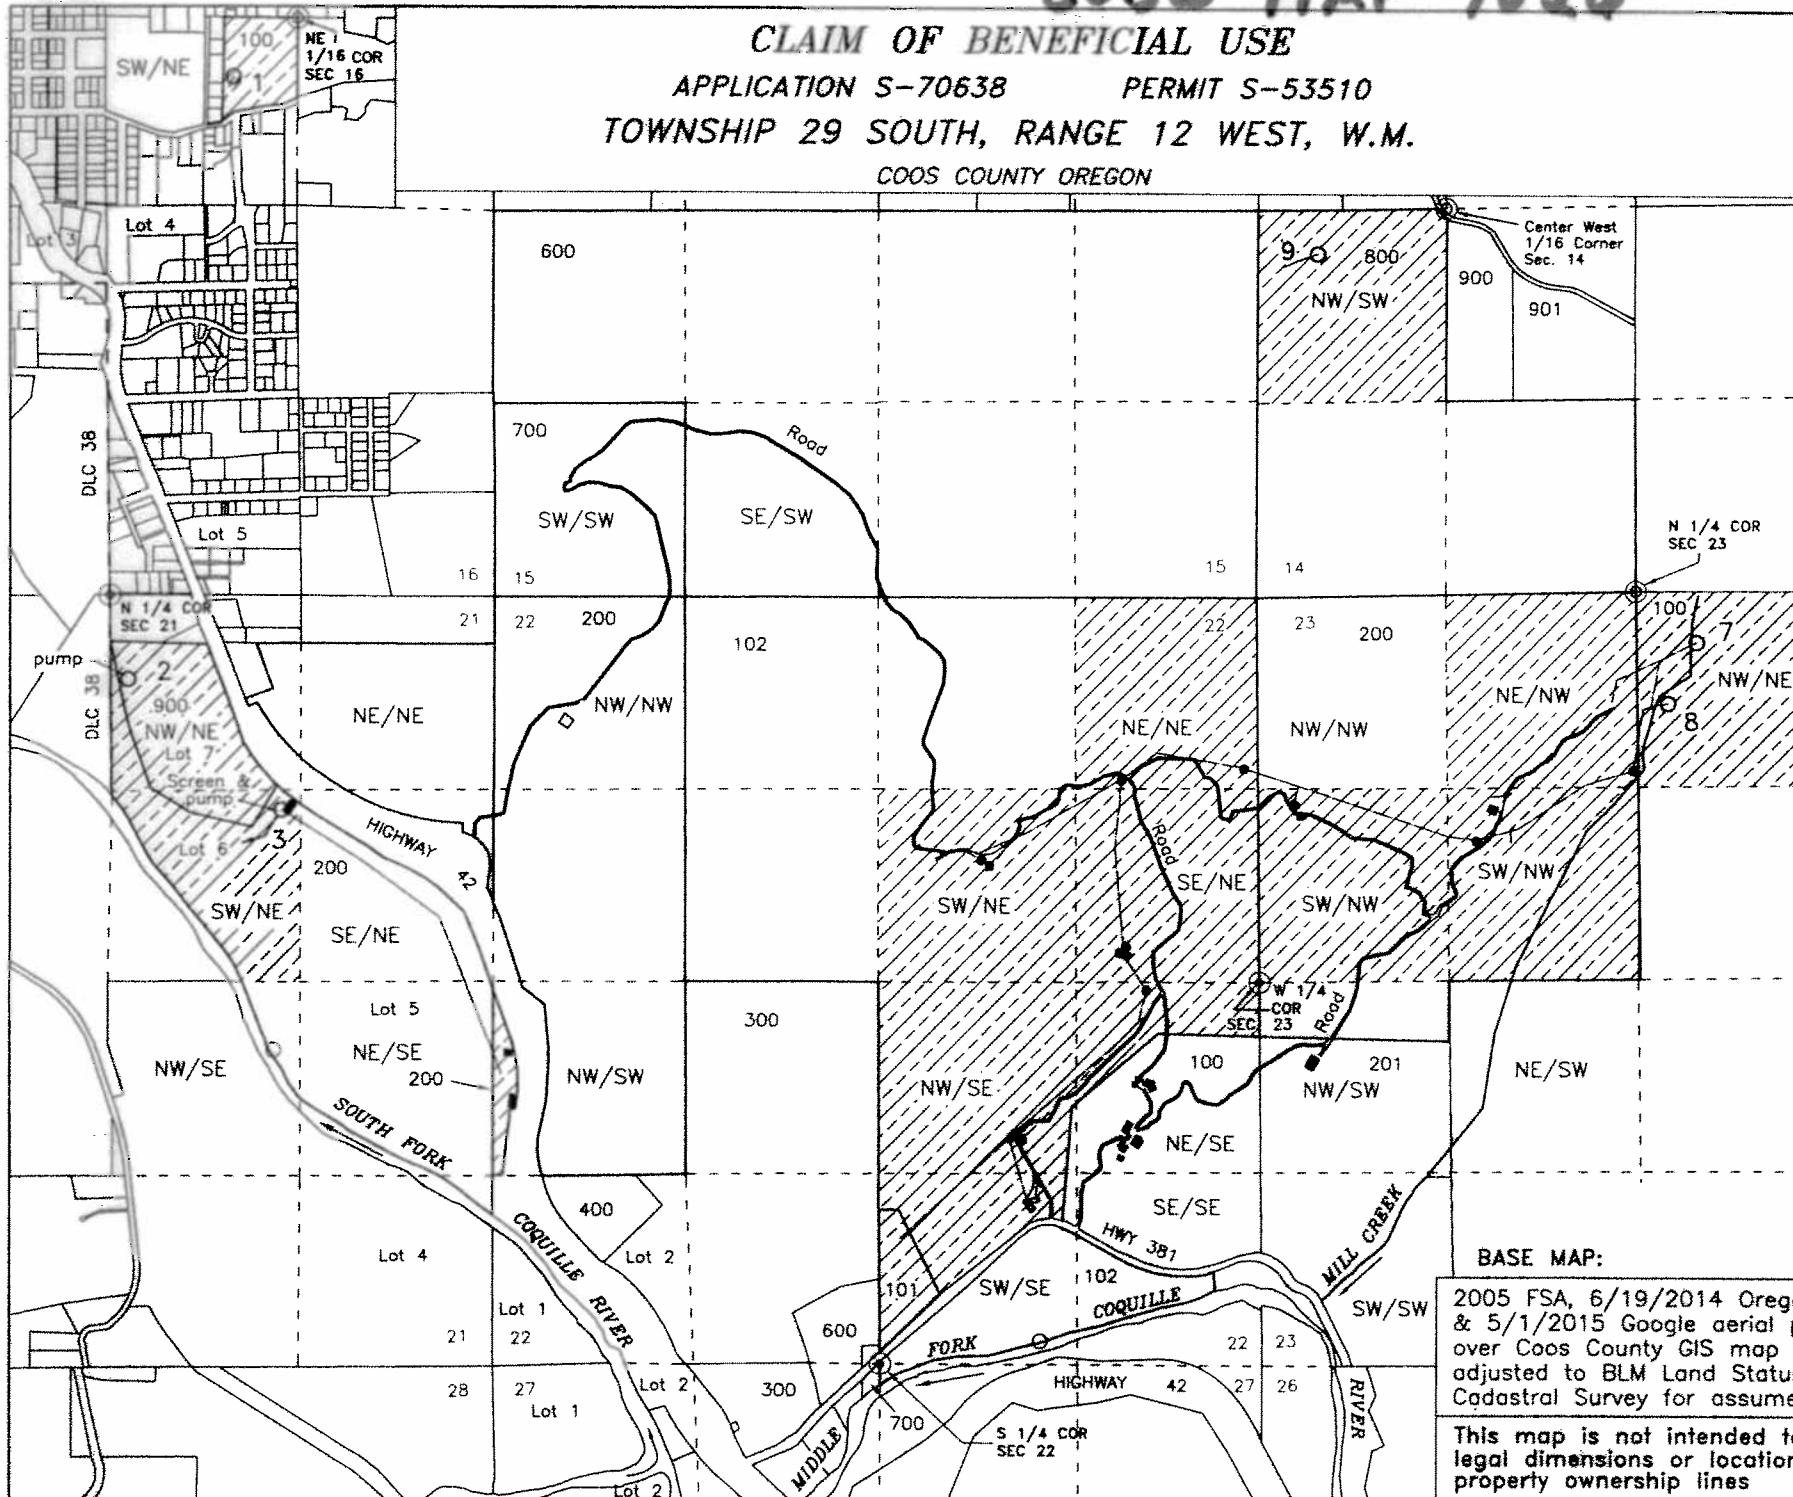


RECEIVED BOARD

SEP 14 2016

SALEM, OR

1026

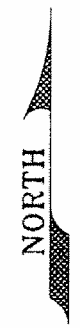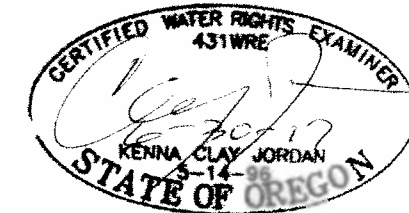

BASE MAP:
 2005 FSA, 6/19/2014 Oregon Map & 5/1/2015 Google aerial photos over Coos County GIS map and adjusted to BLM Land Status & Cadastral Survey for assumed best fit

This map is not intended to provide legal dimensions or locations of property ownership lines

Scale
 1 inch = 1320 feet

JORDAN ENGINEERING
 460 JORDAN LANE
 ROSEBURG, OR 97471
 (541) 673-1931

2/25/2016 n.e.d.
 Rev-6/16/2016 n.e.d.