


T.4S. R.1E. Section 5, W.M.

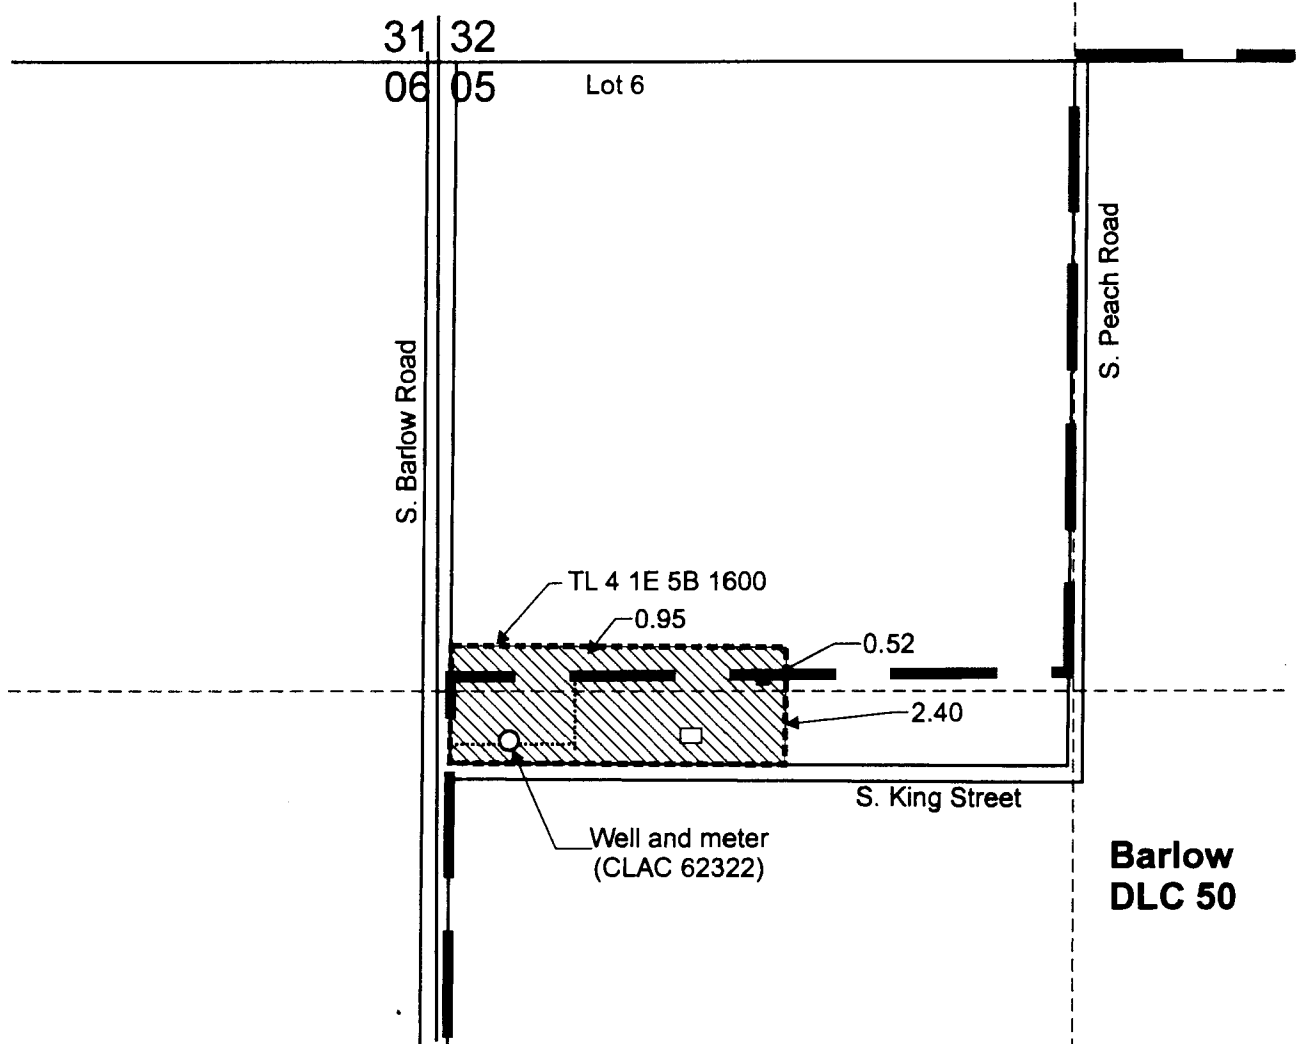


Well (CLAC 62322) is located 1,425 feet south and 150 feet east from the NW corner of Section 5.

 Area (3.87 Acres) irrigated under Application G-16476, Permit G-16033.

 Tax lot boundary


 Donation Land Claim

 Irrigation main line

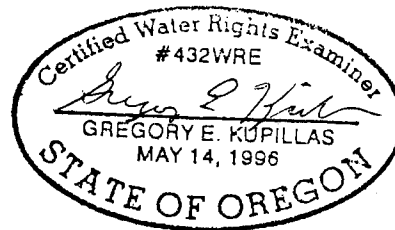

EXPIRATION DATE: 6/30/2017

Scale: 1" = 400'

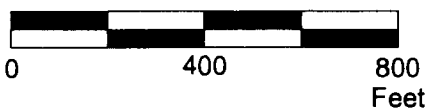

This map was prepared for the purpose of identifying the location of a water right only and is not intended to provide legal dimensions or location of property ownership lines.



Claim of Beneficial Use Map
Application G-16476, Permit G-16033

Sean and Barbara McVicker
T.4S. R.1E. Section 5 W.M.

Pacific Hydro-Geology Inc.

01/2013