


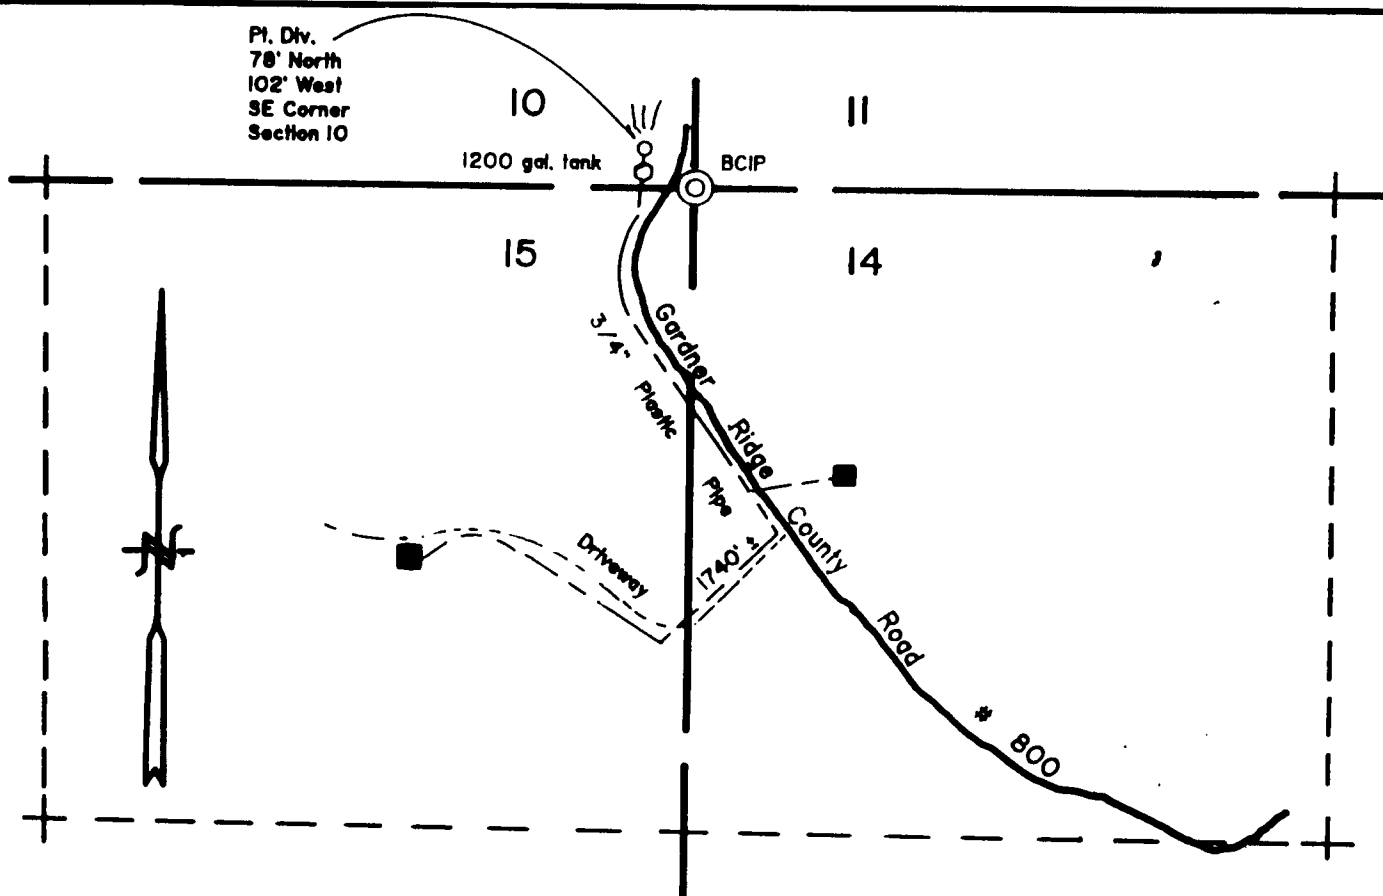

The preparation of this map was for the purpose of identifying the location of the proposed water right and has no intent to provide dimensions or location of property lines.

T 40 S, R 13 W, W.M.

Section 14 & 15

FINAL PROOF SURVEY

UNDER

Application # 71449 Permit # ~~50269~~
31456

IN THE NAME OF

LELAND R. and BETTY M. HALL

Surveyed September 16, 1992, by H.J. Newhouse

Scale - 1" = 400'

REVISED SEPTEMBER 26, 1996

RECEIVED

SEP 30 1996

WATER RES. DIVISION DEPT.
SALEM OREGON

