
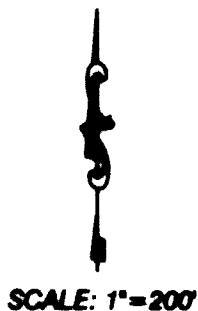


T. 5N. R10W., W.M.


Peter Sroufe

SW 1/4 NW 1/4 OF SECTION 32
CLATSOP COUNTY
81865 Hwy. 101 N
CANNON BEACH, OR. 97110

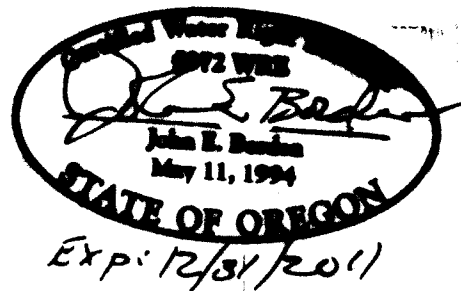

LEGEND

- PROPERTY LINE
- USGS GRID
- ROADWAY
- PIPING
- ⊕ PLS CORNERS

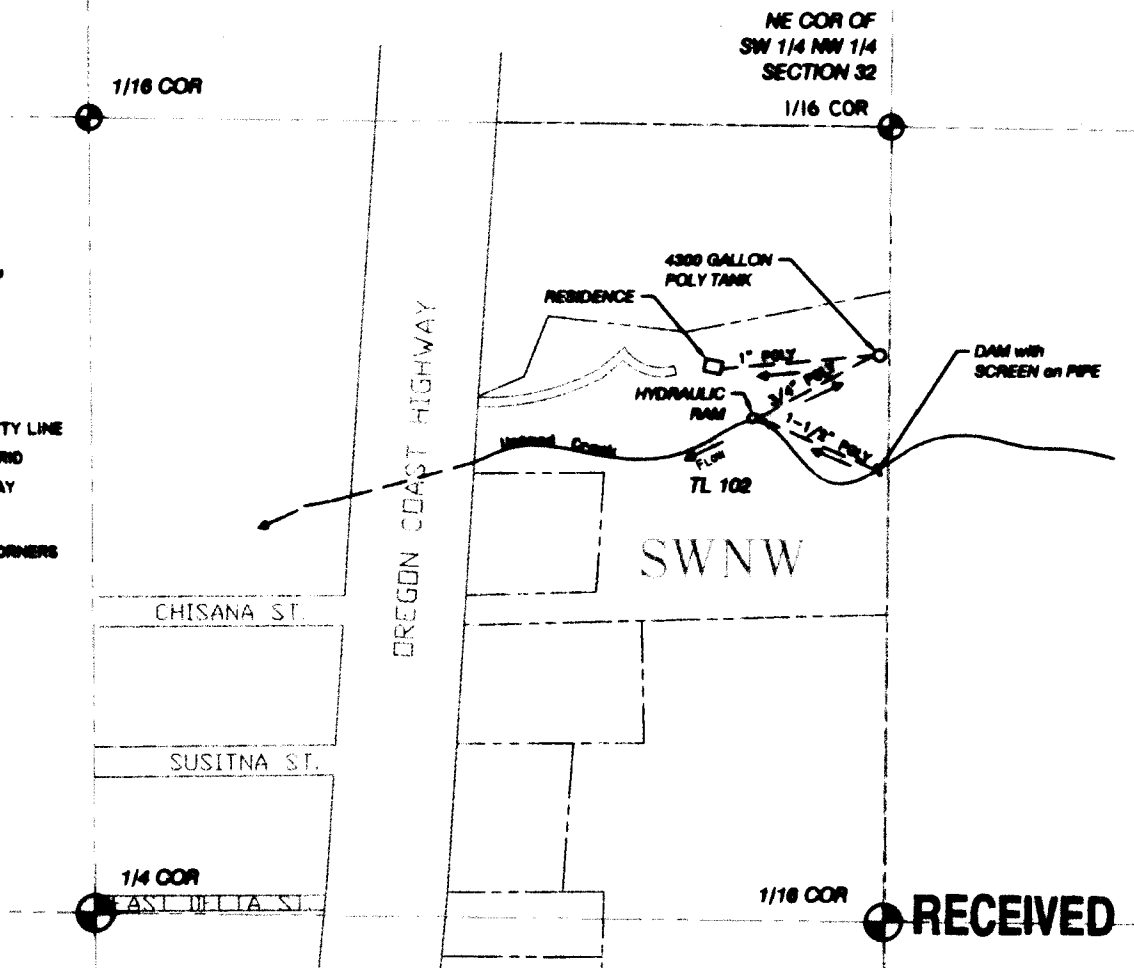

SURVEY

AND CLAIM OF BENEFICIAL USE UNDER
APPLICATION No. S-72642, PERMIT No. S-52682
IN THE NAME OF
PETER SROUFE

FOR DOMESTIC USE EXPANDED FOR ONE HOUSEHOLD
FROM AN UNNAMED CREEK, TRIBUTARY TO THE PACIFIC OCEAN
SURVEYED 5-25-2011, BY JOHN E. BORDEN, CWRE

NOTE: P.O.D. (Point of Diversion) is located 1/4
west and 572 feet south from the NW 1/4 corner of
Section 32.

PREPARATION OF THIS MAP IS FOR THE PURPOSE OF
IDENTIFYING THE LOCATION OF THE WATER RIGHT
ONLY. THERE IS NO INTENT TO PROVIDE DIMENSIONS
OR LOCATION OF PROPERTY OWNERSHIP LINES.

JOHN BORDEN CONSULTING

5597 RIVER STREET
WEST LINN, OR. 97068
503-723-4257

Sroufe Water Right

FILE PATH & NAME: JED:SRoufe_05_28_11-JEB-6-18-2011.DWG