
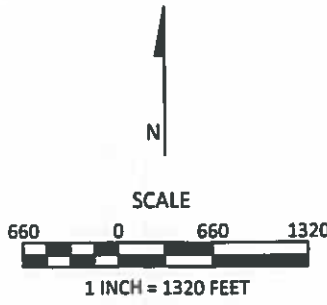
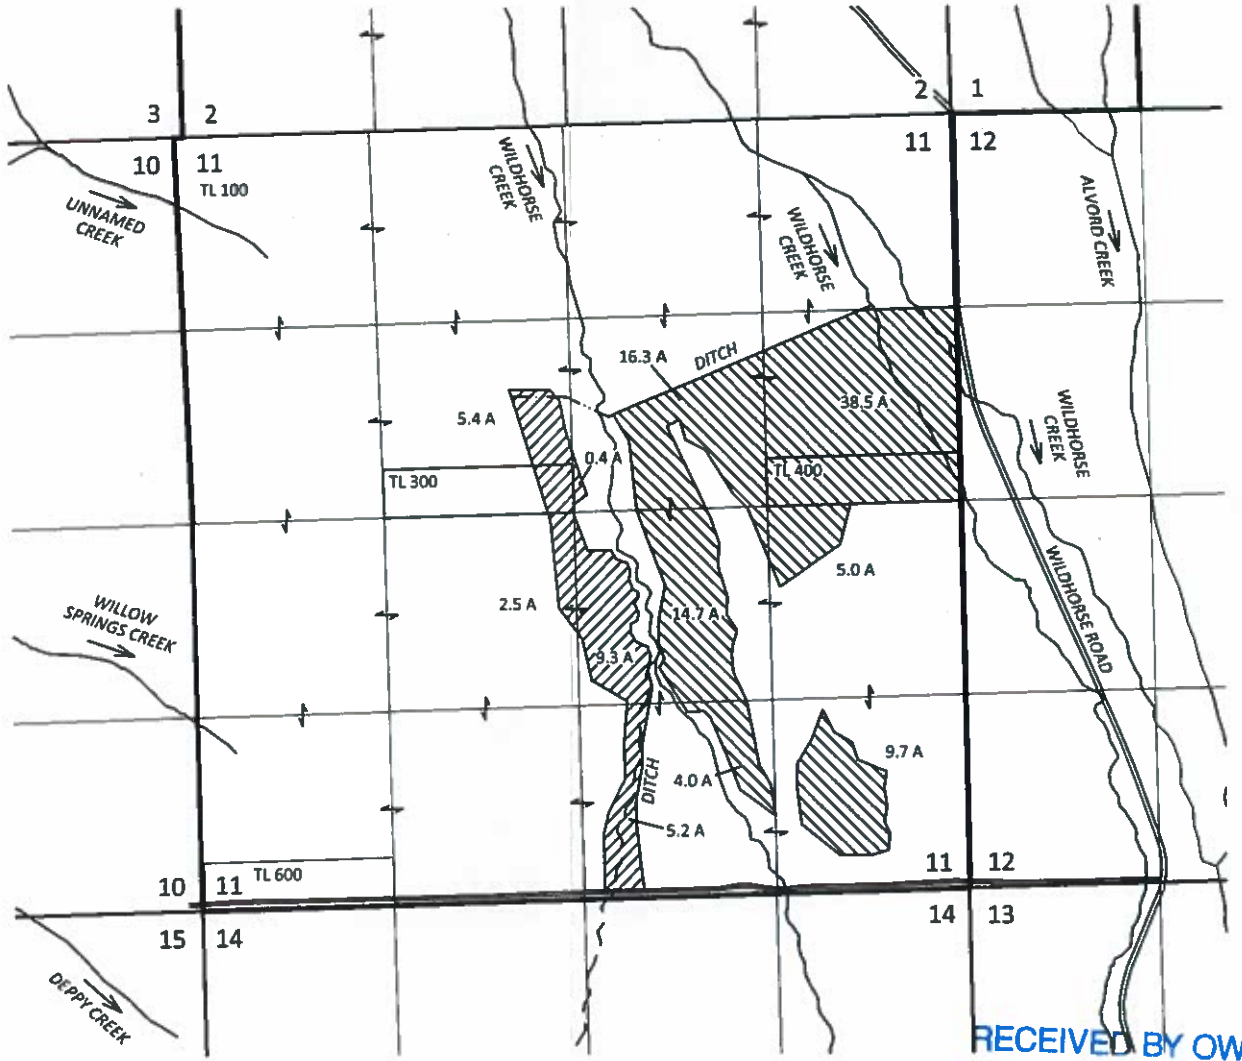


TRANSFER APPLICATION MAP Certificates 88588 & 88589 Section 34, T34S, R33E and Sections 1, 2 & 11, T35S, R33E, W.M., Harney County, Oregon

George Stroemple

FROM MAP

TO MAP

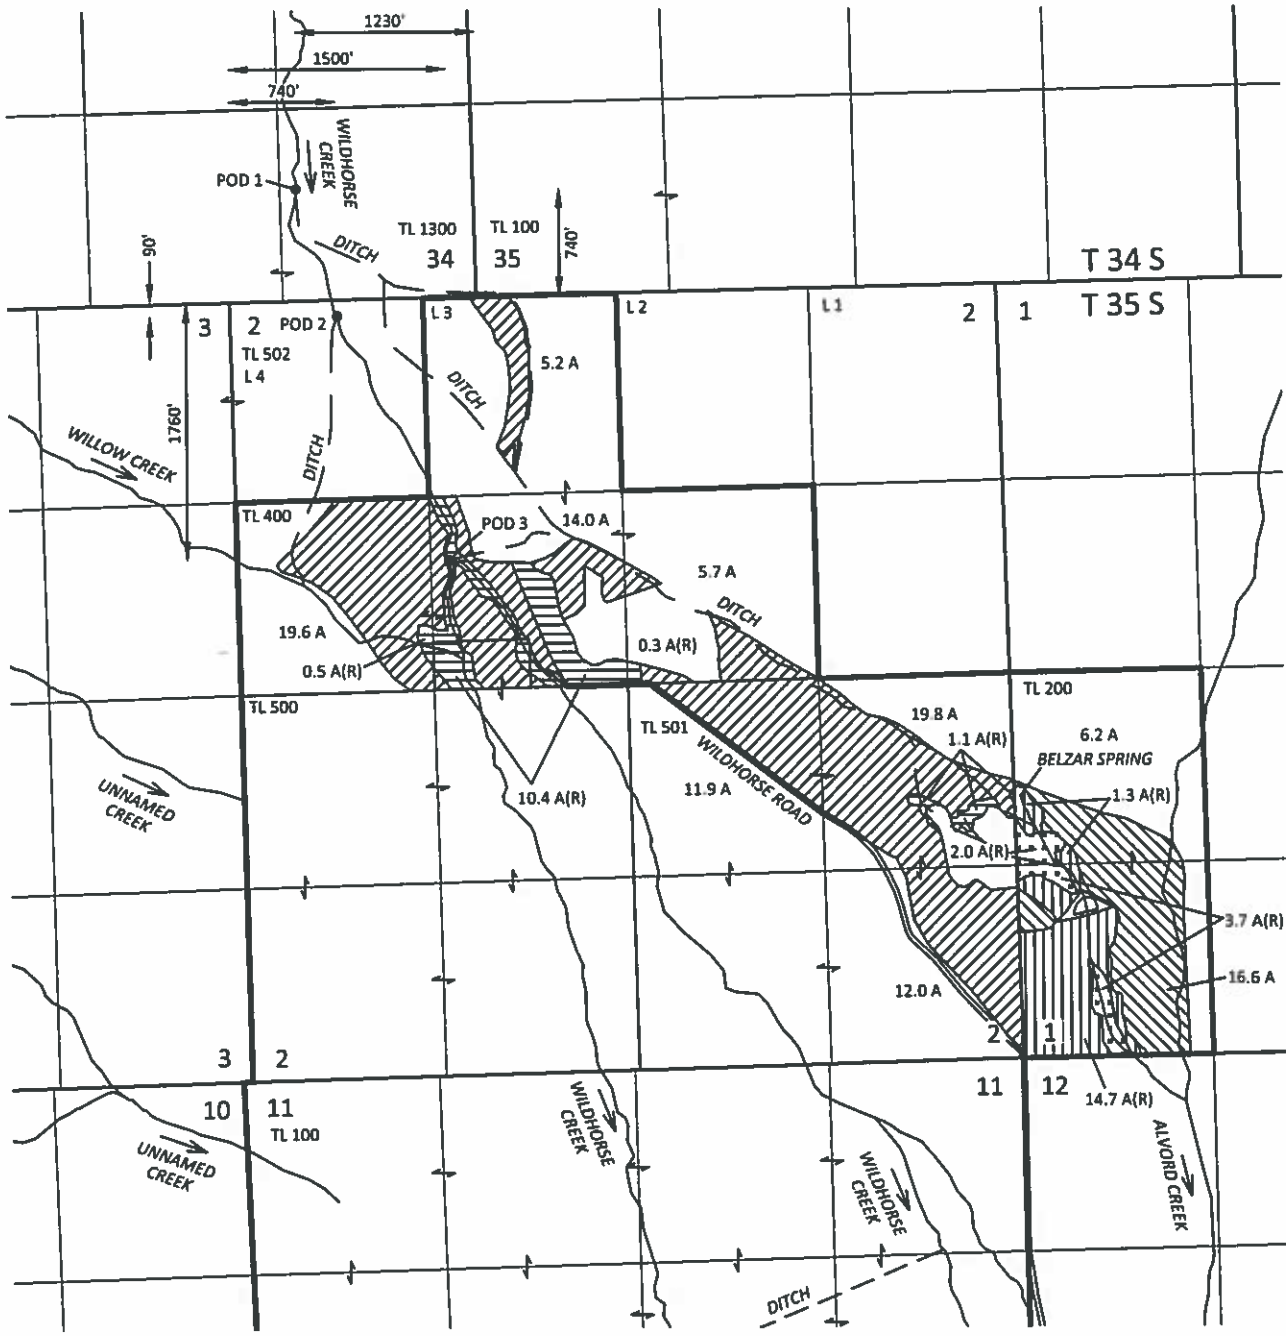

December 22, 2016

This map is not intended to provide legal dimensions or locations of property ownership lines

Figure 1

RECEIVED BY OWRD

JAN 19 2017

SALEM, OR

EXPLANATION

FROM LANDS	TO LANDS	REMAINING RIGHTS
CERTIFICATE 88588 (88.2 A) IRRIGATION PRIORITY: 6/27/1978	CERTIFICATE 88588 (88.2 A) IRRIGATION PRIORITY: 6/27/1978	CERTIFICATE 88588 (12.3 A) IRRIGATION PRIORITY: 6/27/1978
CERTIFICATE 88589 (22.8 A) IRRIGATION PRIORITY: 6/27/1978	CERTIFICATE 88589 (22.8 A) IRRIGATION PRIORITY: 6/27/1978	CERTIFICATE 88589 (16.0 A) IRRIGATION PRIORITY: 6/27/1978
POINT OF DIVERSION (POD)	PIPELINE (APPROX.)	CERTIFICATE 88589 (5.7 A) SUPPLEMENTAL IRRIGATION PRIORITY: 6/27/1978
DITCH		

DRAFT


RECEIVED

MAR 20 2008


**WATER RESOURCES DEPT

CLAIM of BENEFICIAL USE MAP
for
George Stroemple
Under Permits 43218 & 43219

T.34 & 35 S., R. 33 E., W.M.

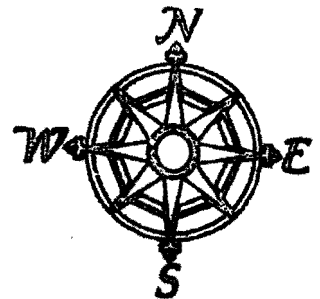

1" = 1320'

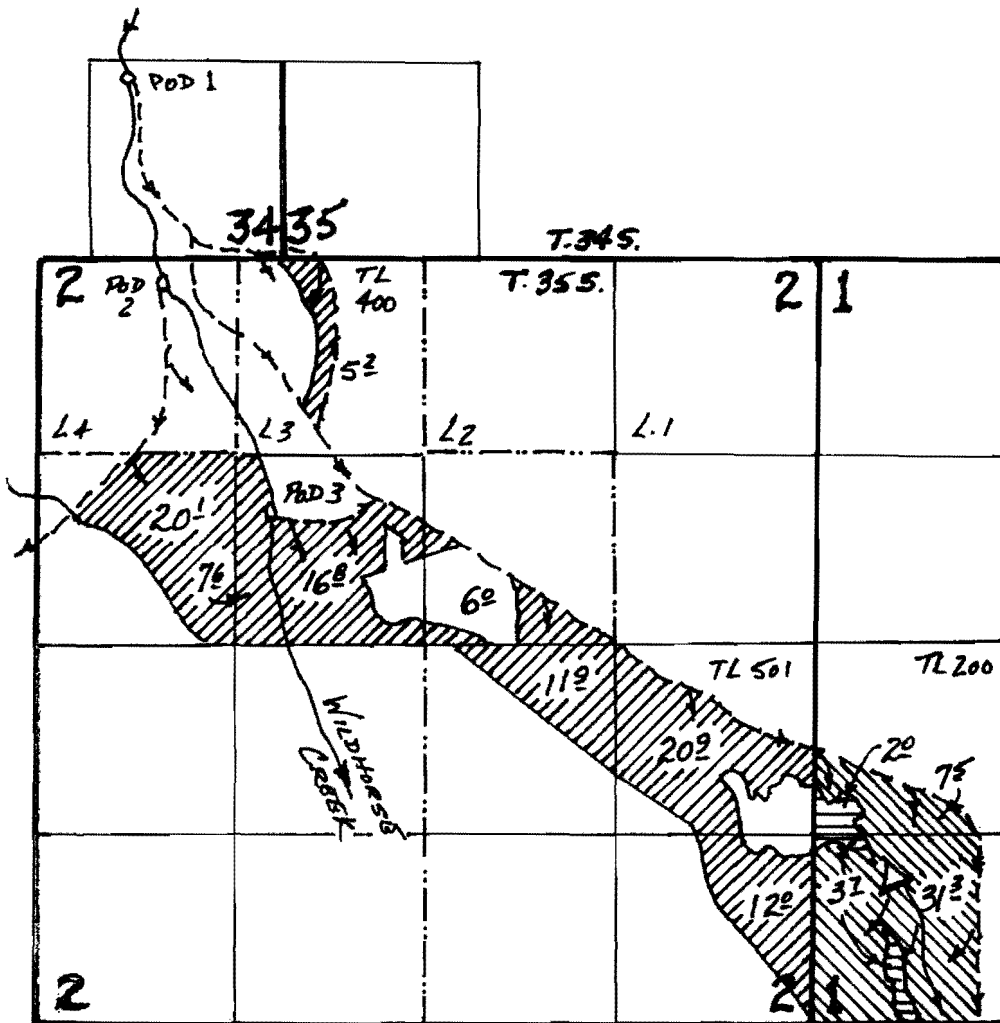

A# 57575, Permit 43218



A# 57576, Permit 43219



Primary
Supplemental

AMENDED 03/26/13

Ronald H. Schuler


POD's Located:

#1- 1250' N. & 1060' W.;

#2- 180' S. & 830' W.;

#3- 1750' S. & 100' W.;

all from the SE Corner Section **34**

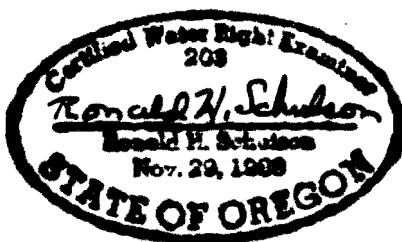

This map is for the purpose of identifying the location of water rights only, and is not intended to provide legal dimensions or locations of property lines.