

T. 3N. R10W., W.M.

Diane Lorette-Willis


NW 1/4 SE 1/4 OF SECTION 25

TILLAMOOK COUNTY

35755 Hwy. 53

NEHALEM, OR. 97131

PREPARATION OF THIS MAP IS FOR THE
PURPOSE OF IDENTIFYING THE LOCATION OF
THE WATER RIGHT ONLY. THERE IS NO
INTENT TO PROVIDE DIMENSIONS OR
LOCATION OF PROPERTY OWNERSHIP LINES.

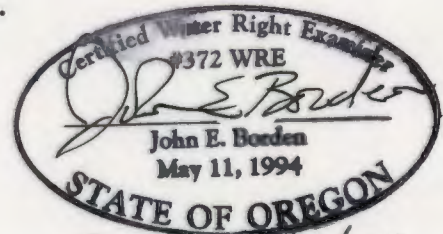

Expires: 12/31/2011

NE 1/16 COR
NW 1/4 SE 1/4
SECTION 25

NWSE

EXEMPT-USE WELL
(Human Consumption)

P.O.D.
#1

1000 Gallon TANK
WITH OVERFLOW
TO CREEK

TL 1100

Irrigated
Area

HOUSE

Creek

Flow

2" PVC

PIPELINE

2" PVC

BARNs

(Stock Watering)

TL 1101

NOTES:

P.O.D. (POINT OF DIVERSION) IS LOCATED 218 FT.
WEST AND 414 FT. SOUTH OF THE NE CORNER OF THE
NW QUARTER OF THE SE QUARTER OF SECTION 25

SURVEY

AND CLAIM OF BENEFICIAL USE UNDER
APPLICATION No. S-73729, PERMIT No. S-52067
IN THE NAME OF
DIANE LORETTE-WILLIS
FOR
DOMESTIC USE, IRRIGATION AND STOCK WATERING
FROM AN UN-NAMED STREAM IN THE NEHALEM RIVER BASIN
SURVEYED MAY 25, 2011, BY JOHN E. BORDEN, CWRE

RECEIVED

SEP 23 2011

SCALE: 1"=200'

WATER RESOURCES DEPT
SALEM, OREGON

LEGEND

- PROPERTY LINE
- USGS GRID
- ROADWAY
- PIPE
- SECTION 1/16TH CORNER

JOHN BORDEN CONSULTING

5597 RIVER STREET
WEST LINN, OR. 97068
503-723-4257

Willis Water Right

FILE PATH & NAME: J3/D:/WILLIS_052611.DWG-JEB-7-12-2011