


SCALE 1" = 400'

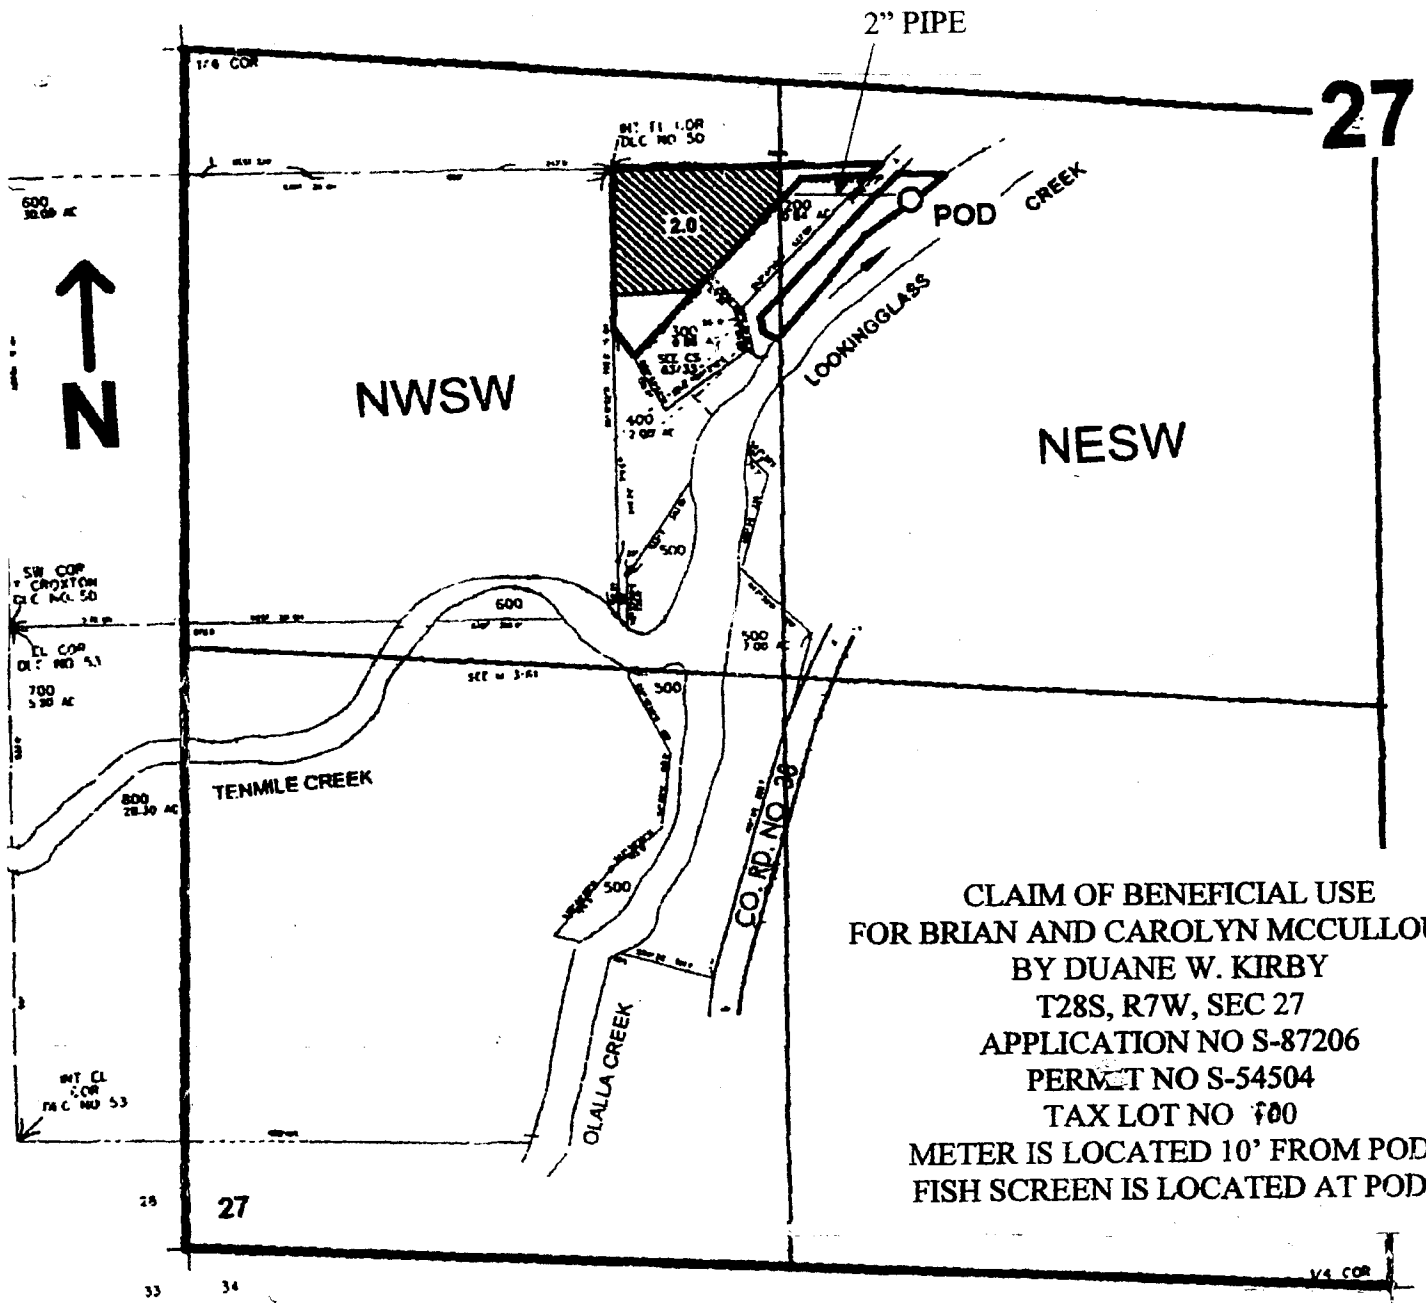

CLAIM OF BENEFICIAL USE
 FOR BRIAN AND CAROLYN MCCULLOUGH
 BY DUANE W. KIRBY
 T28S, R7W, SEC 27
 APPLICATION NO S-87206
 PERMIT NO S-54504
 TAX LOT NO 700
 METER IS LOCATED 10' FROM POD
 FISH SCREEN IS LOCATED AT POD

POD is located 175 ft. S. and 1010 ft. W. from the center of Sec. 27

THE PURPOSE OF THIS MAP IS TO IDENTIFY THE LOCATION OF THE WATER RIGHT. IT IS NOT INTENDED TO PROVIDE INFORMATION RELATIVE TO THE LOCATION OF PROPERTY OWNERSHIP BOUNDARY LINES.

