


Sections 34 & 35, T5S, R5W, W.M., Yamhill County

Transfer T-11478  
CLAIM OF BENEFICIAL USE MAP  
Christensen Farms LLC

**RECEIVED**

NOV 10 2016

WATER RESOURCES DEPT  
SALEM, OREGON

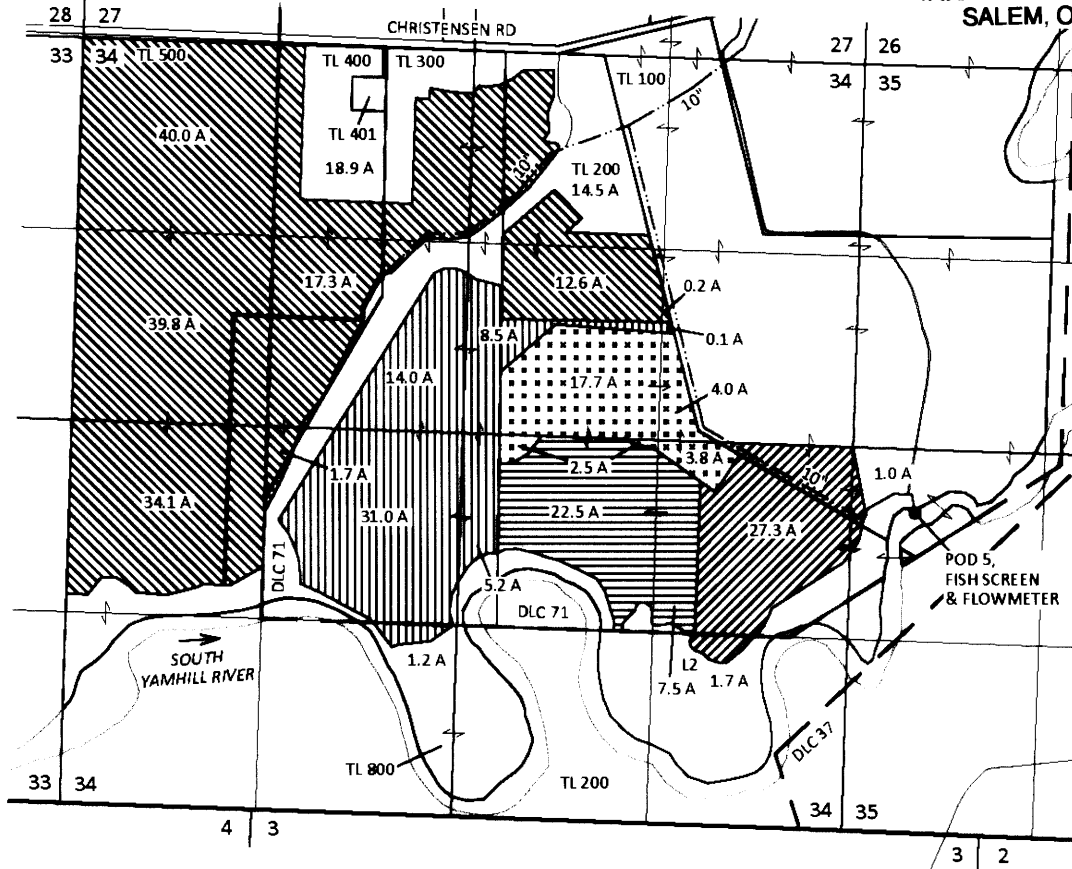








POD 5 LOCATION: 2180 FT N AND 510 FT E  
FROM SW CORNER OF SECTION 35, T5S, R5W, W.M.

BLM DATA (SEE EXHIBIT C) INDICATES THE SOUTHERN BOUNDARY OF DLC 71  
COINCIDES WITH QQ LINE

SITE INSPECTION CONDUCTED JULY 26, 2016

**EXPLANATION**

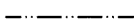-  CANCELED CERTIFICATE 16716  
30.0 ACRES  
PRIORITY: 5/4/1944
-  CANCELED CERTIFICATE 19861  
30.0 ACRES  
PRIORITY: 4/18/1947
-  CANCELED CERTIFICATE 22486  
28.0 ACRES  
PRIORITY: 3/31/1950
-  CANCELED CERTIFICATE 49961  
60.0 ACRES  
PRIORITY: 7/6/1976
-  CANCELED CERTIFICATE 64516  
179.1 ACRES  
PRIORITY: 2/28/1979
-  POINT OF DIVERSION (POD)
-  PIPELINE (APPROX.)



**SCALE**




1 INCH = 1320 FEET

November 3, 2016

This map is not intended to provide legal  
dimensions or locations of property  
ownership lines

**MAP 1 OF 2**

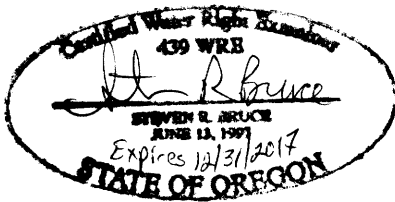


**SKOOKUM**  
WATER ASSOCIATES, INC.

1626 VICTORIAN WAY  
EUGENE, OR 97401  
(503) 319-8926

Sections 26, 27, 34 & 35, T5S, R5W, W.M., Yamhill County

Transfer T-11478  
CLAIM OF BENEFICIAL USE MAP  
Christensen Farms LLC

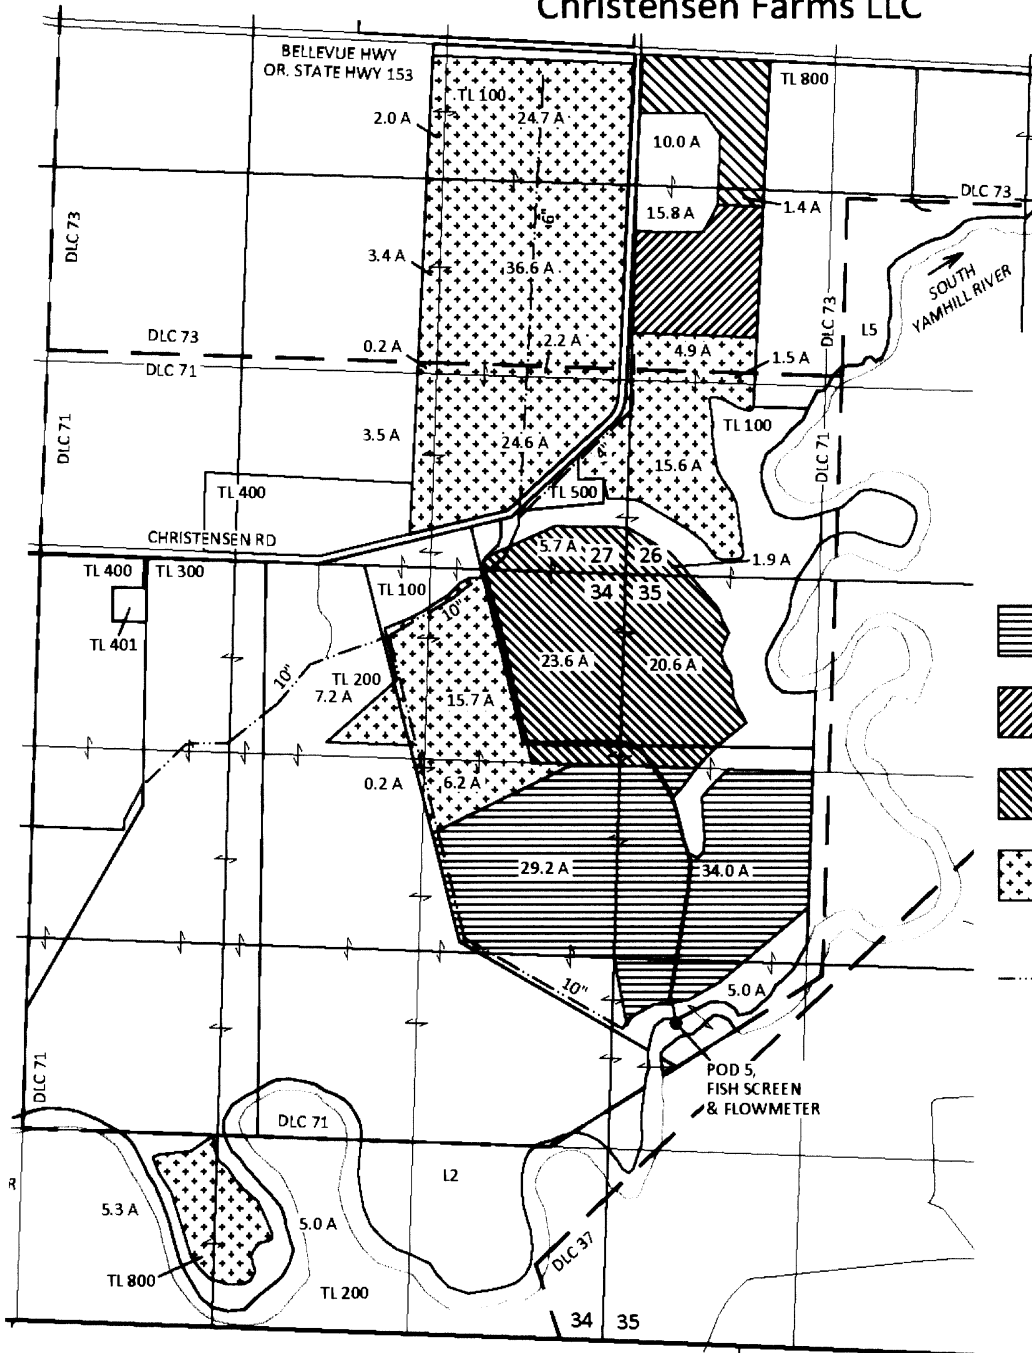


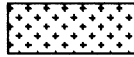




**RECEIVED**

NOV 10 2016

WATER RESOURCES DEPT  
SALEM, OREGON

**EXPLANATION**

-  CANCELED CERTIFICATE 47042  
68.2 ACRES  
PRIORITY: 5/7/1974 & 6/3/1974
-  CANCELED CERTIFICATE 49960  
15.8 ACRES  
PRIORITY: 7/6/1976
-  CANCELED CERTIFICATE 50648  
63.2 ACRES  
PRIORITY: 5/4/1977
-  CANCELED CERTIFICATE 87465  
158.8 ACRES  
PRIORITY: 7/8/1983
-  POINT OF DIVERSION (POD)
-  PIPELINE (APPROX.)

SITE INSPECTION CONDUCTED  
JULY 26, 2016



**SCALE**



1 INCH = 1320 FEET

November 3, 2016

This map is not intended to provide legal  
dimensions or locations of property  
ownership lines

**MAP 2 OF 2**

POD 5 LOCATION: 2180 FT N AND 510 FT E  
FROM SW CORNER OF SECTION 35, T5S, R5W, W.M.

BLM DATA (SEE EXHIBIT C) INDICATES THE SOUTHERN BOUNDARY OF DLC 71  
COINCIDES WITH QQ LINE

**SKOOKUM**  
WATER ASSOCIATES INC  
1626 VICTORIAN WAY  
EUGENE, OR 97401  
(503) 319-8926

