


CLAIM OF BENEFICIAL USE
 FOR WAYNE PARKER
 BY DUANE W. KIRBY
 T25S R6W WM SEC 30,31
 T25S R7W WM SEC 25,36
 APPLICATION NO S-87652
 PERMIT NO S-54705
 FISH SCREEN IS LOCATED AT POD
 METER IS LOCATED 100' FROM THE POD
 SCALE 1"= 400'

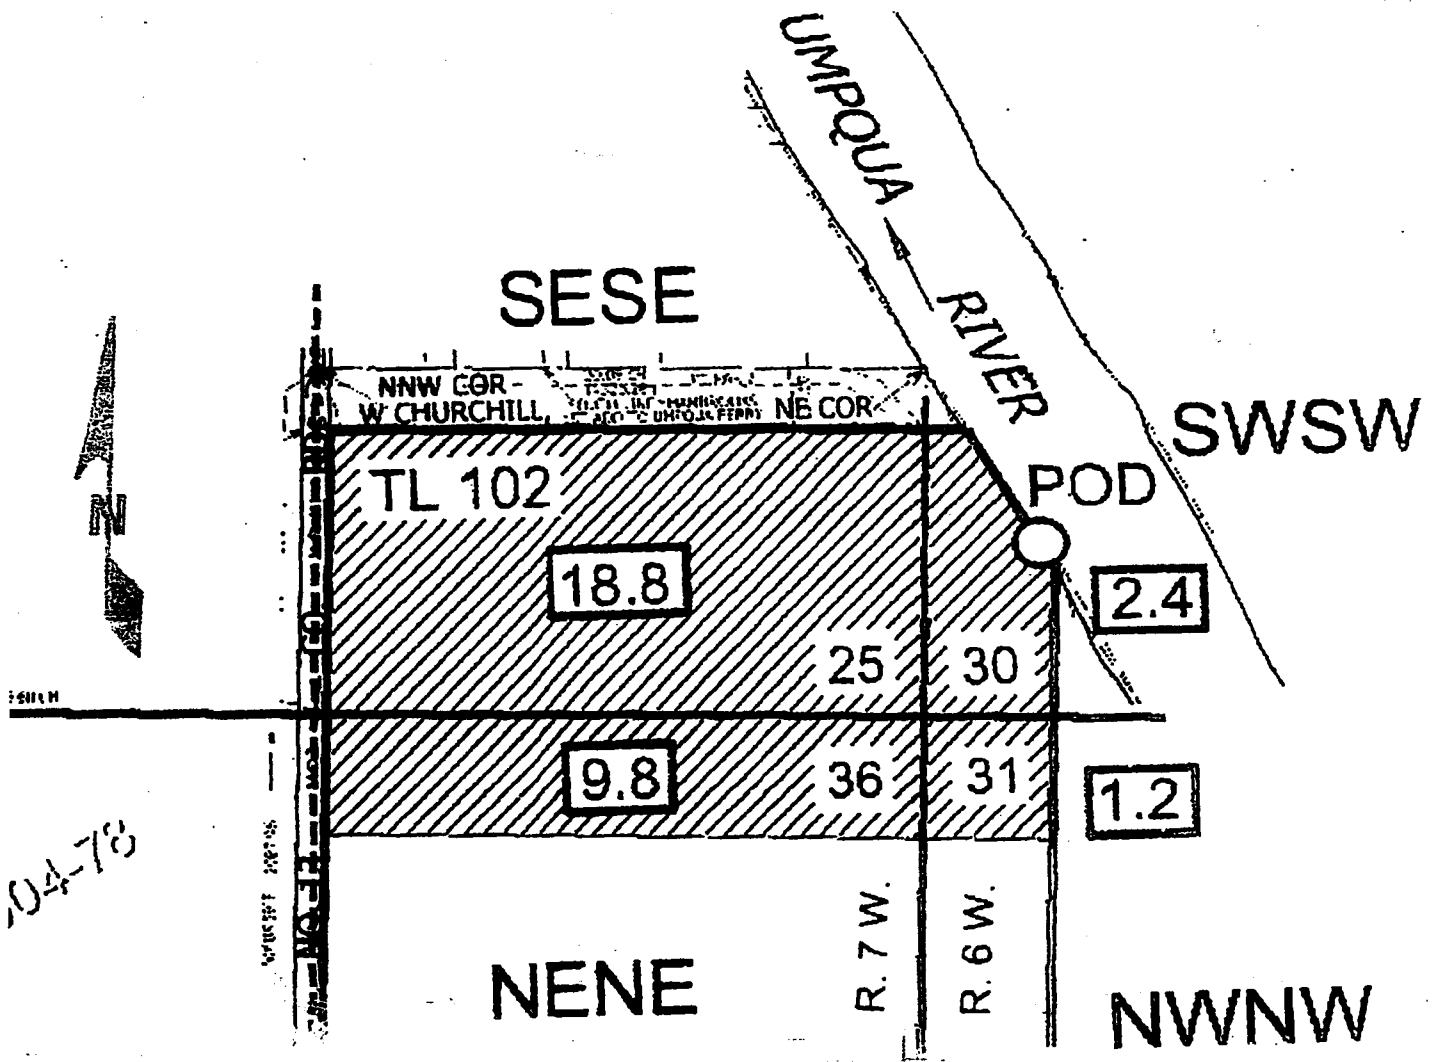

FOD is located 390 ft. N. and 250 ft. E. from the SW corner of Sec. 30

THE PURPOSE OF THIS MAP IS TO IDENTIFY THE LOCATION OF THE WATER RIGHT. IT IS NOT INTENDED TO PROVIDE INFORMATION RELATIVE TO THE LOCATION OF PROPERTY OWNERSHIP BOUNDARY LINES.

