

CLAIM OF BENEFICIAL USE MAP

LOCATED IN THE SW 1/4 OF THE NE 1/4 AND THE SE 1/4 OF THE NW 1/4
OF SECTION 27, TOWNSHIP 30 SOUTH, RANGE 14 WEST, W.M.

CURRY COUNTY, OREGON
APPLICATION S-77155, PERMIT S-53009


DATE: JANUARY 31, 2013

SURVEY METHOD:

THE POD, STORAGE TANKS AND STRUCTURE LOCATIONS WERE
MEASURED FROM THE NORTHWEST CORNER OF SECTION 27 BY
CONVENTIONAL TOTAL STATION TRAVERSE. THE PIPE RUNNING
FROM THE POD TO THE STORAGE TANKS WAS LOCATED BY
AERIAL PHOTO INTERPRETATION.

NOTE:

THE POINT OF DIVERSION IS LOCATED 2193 FEET SOUTH AND 4144 FEET
EAST OF THE NORTHWEST CORNER OF SECTION 27, T.30S., R.14W., W.M.

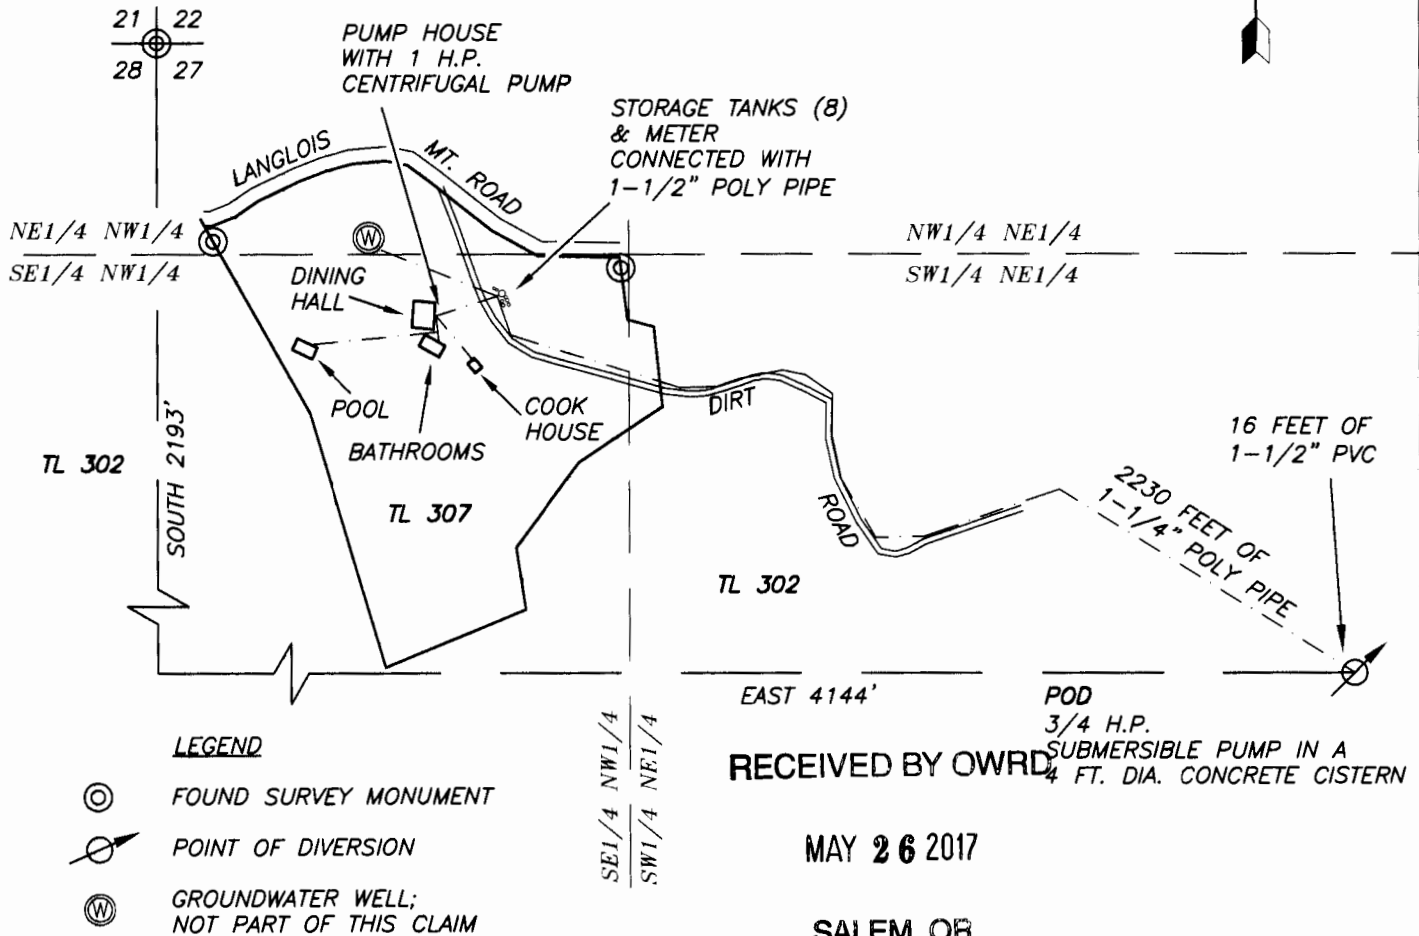

705 S. 4TH ST.
P.O. BOX 118
COOS BAY, OREGON 97420

PHONE: (541) 267-2872
FAX: (541) 267-0588
www.stuntzner.com

Engineering - Land Surveying - Forestry - Land Planning - Water Rights

JOB #: 112-197

DATE: Feb. 2013

DRAWN BY: CMW

CHECKED BY: CMW

PREPARED
FOR:

Camp Fircroft Association
Langlois, OR

FILE NAME: 112-197 COBU.dwg

SHEET 1 OF 1