


1060

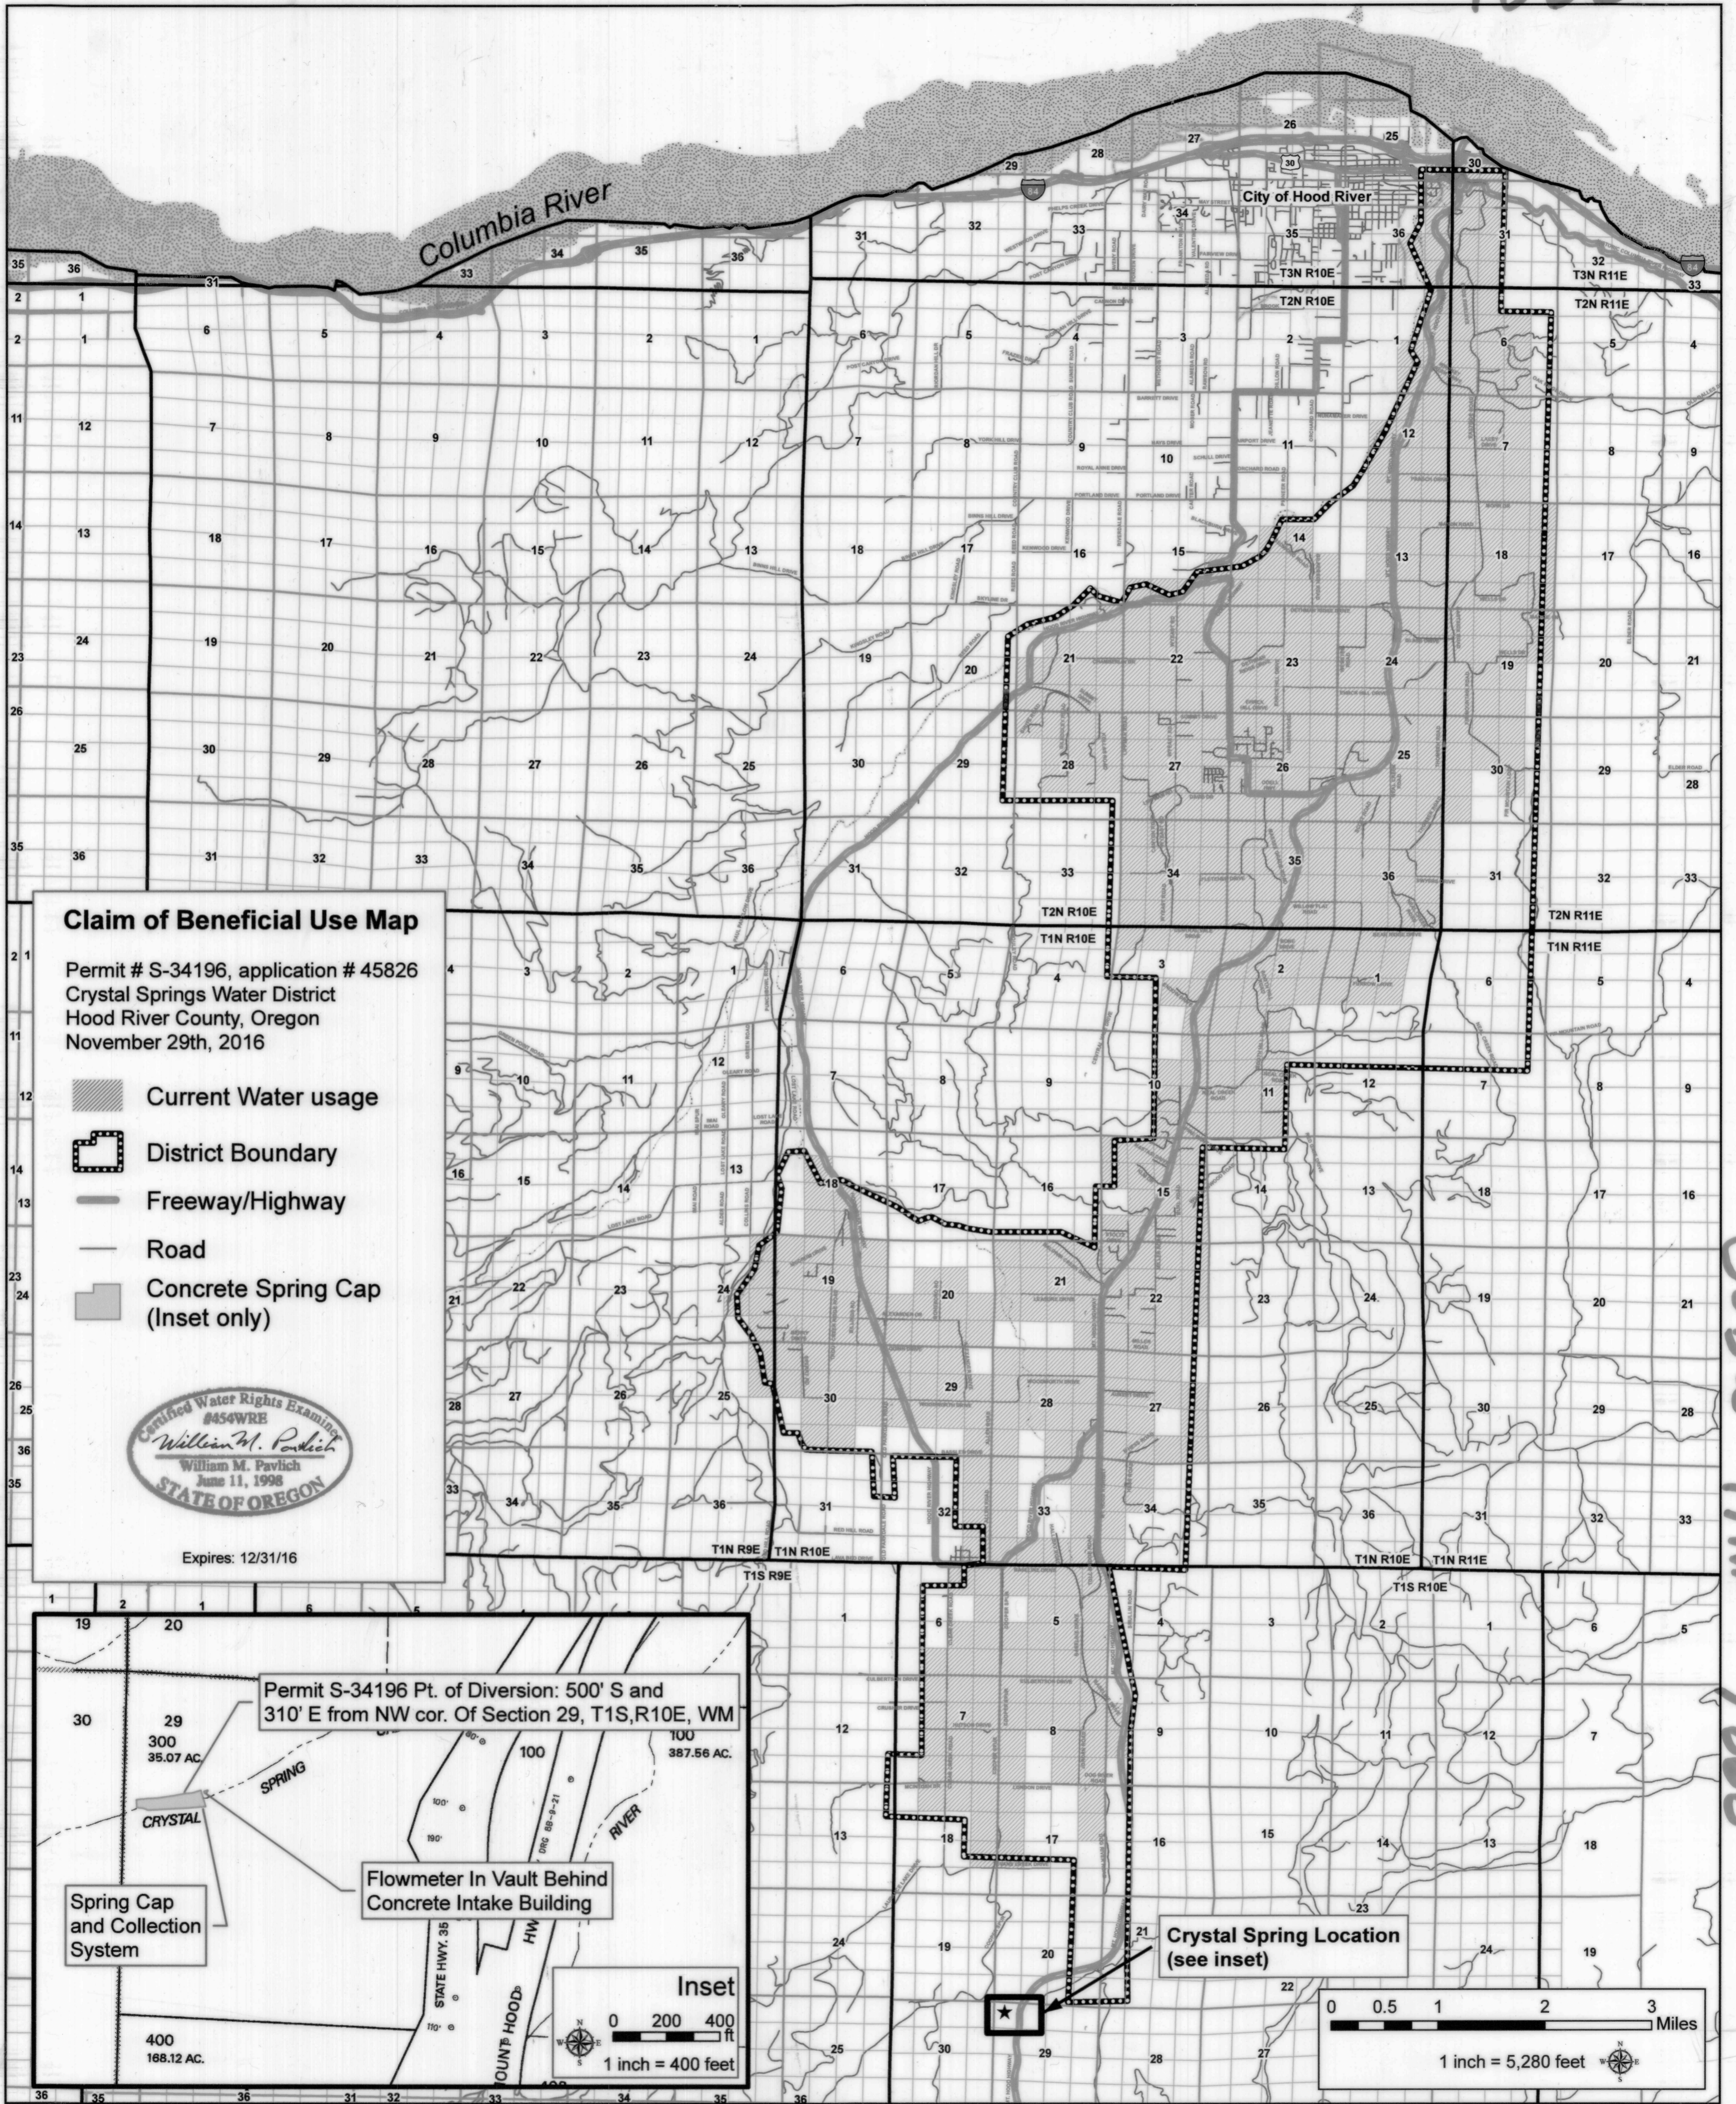

COBE MAP 1060

J:\UtilityDistrictsAndCompanies\CrystalSprings\WaterDistrict\GIS\arcmapdocs\WaterRights_22x17.mxd



Note: This map is not intended to provide legal dimensions or locations of property ownership lines.

RECEIVED
 JAN 04 2017
 OWRD