


776

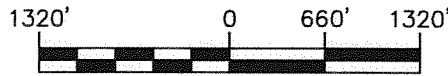

CLAIM OF BENEFICIAL USE AND FINAL PROOF MAP

FOR
CHEYNE BROTHERS, LLC
T41S, R12E, Sec. 14 & 23 W.M.
KLAMATH COUNTY, OREGON

RECEIVED BY OWRD


APPLICATION No. G-15764
PERMIT No. G-15430

JUL 15 2013

SALEM, OR

NOTES:

- THIS MAP WAS PREPARED FROM FIELD MEASUREMENTS, NAIP 2005 AERIAL PHOTOGRAPH, KLAMATH COUNTY TAX MAPS 401214 & 401223 AND OREGON GLO MAPS.
- THE PURPOSE OF THIS MAP IS TO IDENTIFY THE LOCATION OF THE WATER RIGHT ONLY, AND IS NOT INTENDED TO PROVIDE DIMENSIONS OR LOCATION OF PROPERTY LINES.
- FOR TAX LOT INFORMATION, SEE TAX MAPS INCLUDED WITH THIS COBU.
- DATE OF PRIORITY FOR THIS APPLICATION IS MAY 17, 2002.

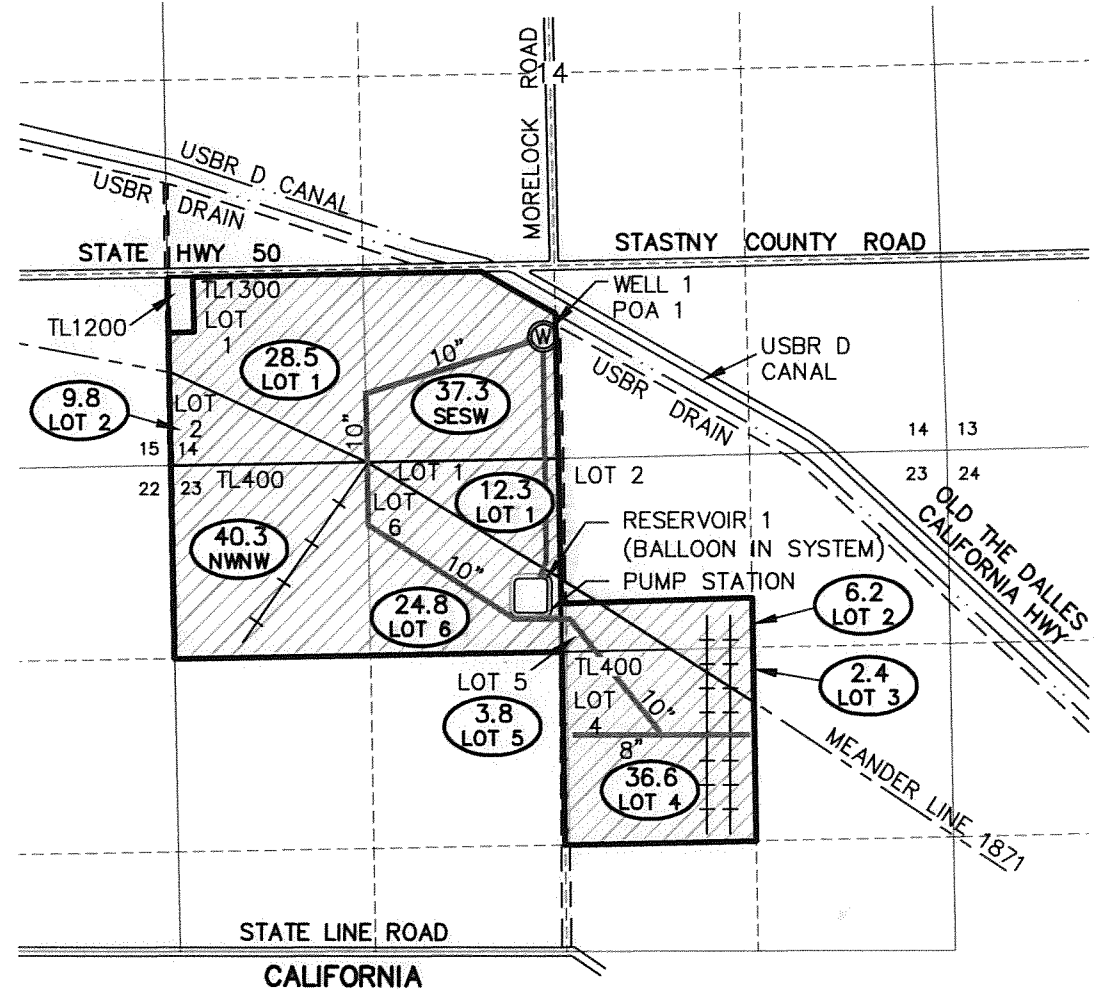


WELL TIE:

THE WELL AND METER ARE LOCATED 2,595' EAST AND 471' SOUTH FROM THE S1/16 OF S15/S14 LOCATED IN THE SE1/4 SW1/4, SECTION 14, T41S, R12E, W.M.

G LOT	1/4 1/4	SECTION	TOWNSHIP	RANGE	PERMITTED ACRES	# IRRIGATED ACRES
1	SW SW	14	41S	12E	27.0	28.5
2	SW SW	14	41S	12E	10.0	9.8
	SE SW	14	41S	12E	36.0	37.3
1	NE NW	23	41S	12E	13.0	12.3
2	NW NE	23	41S	12E	7.0	6.2
3	SW NE	23	41S	12E	4.0	2.4
4	SW NE	23	41S	12E	34.0	36.6
5	NW NE	23	41S	12E	3.0	3.8
6	NE NW	23	41S	12E	27.0	24.8
	NW NW	23	41S	12E	41.0	40.3

TOTAL ACRES IRRIGATED: 202.0 202.0

LEGEND

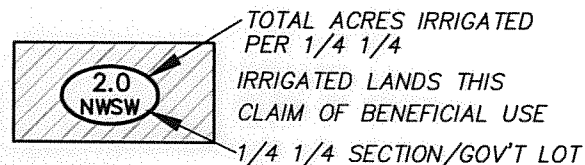

14 SECTION DESIGNATION
TL400 TAX LOT NUMBER

- SECTION LINES
- 1/4 1/4 LINES
- ROADS
- PROPERTY BOUNDARY
- TAX LOT BOUNDARY
- EASEMENTS

- 10" MAIN LINE SIZE
- PIVOT LINE
- 4" WHEEL LINES
- EXISTING P.O.A. (WELL)


Col A. Lentes Authorized Member
Applicant signature



2950 Shasta Way · Klamath Falls, Oregon 97603 · (541) 884-4666 · FAX (541) 884-5335

4-16-13

Oregon · California
CHEYNE_BASE.DWG

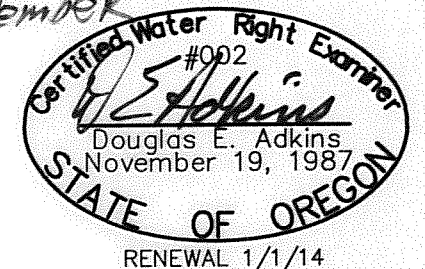

Engineers ▲ Planners ▲ Surveyors

COBU MAP # 776