



T. 23 S., R 12 W., W.M.

LEGEND

- SECTION AND PROPERTY BOUNDARIES
- 1" PVC WATER LINE

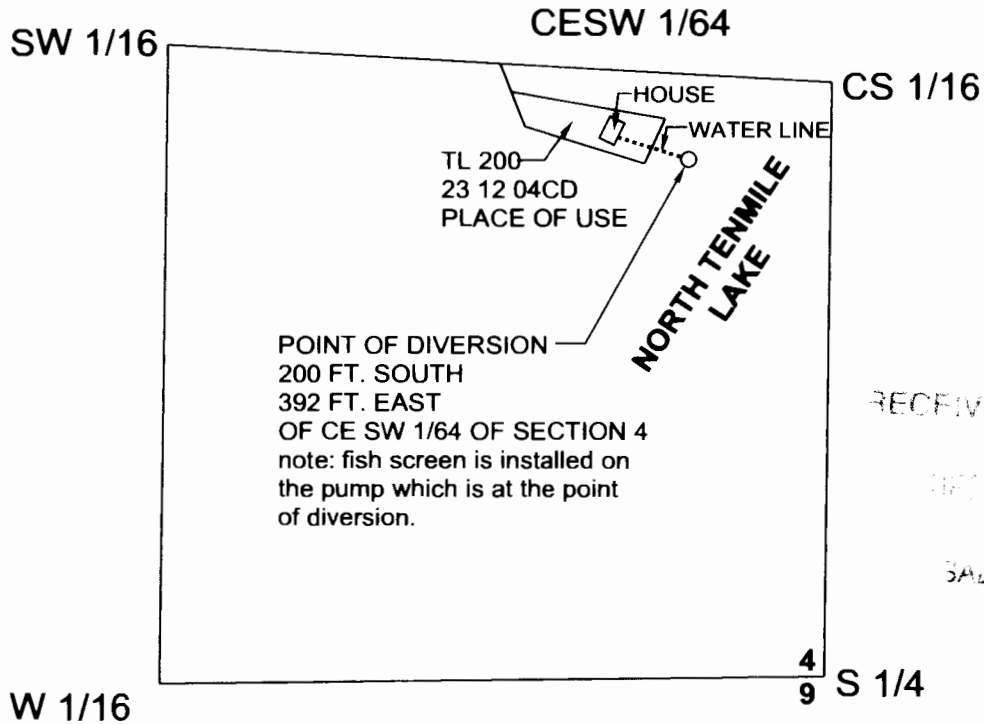

This map is not intended to provide legal dimensions or locations of property ownership lines.

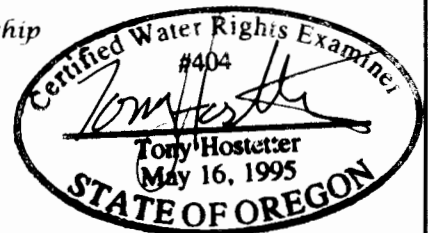

POINT OF DIVERSION
DIV. PT. LOCATED 200 FT. SOUTH & 392' EAST,
FROM THE CE SW 1/64 CORNER OF SECTION 4

SCALE: 1"=400'
FINAL PROOF SURVEY
UNDER

Application No. S-81254 Permit No. 53213
IN THE NAME OF
GREGORY D. AND LESLIE M. HART
Surveyed June 3, 2013, by T.HOSTETTER