


# Instream Transfer Application Map - Certificate 10902

## Authorized Place of Use and Point of Diversion

Township 33 South, Range 7 1/2 East, Sections 3 and 4 (W.M.)

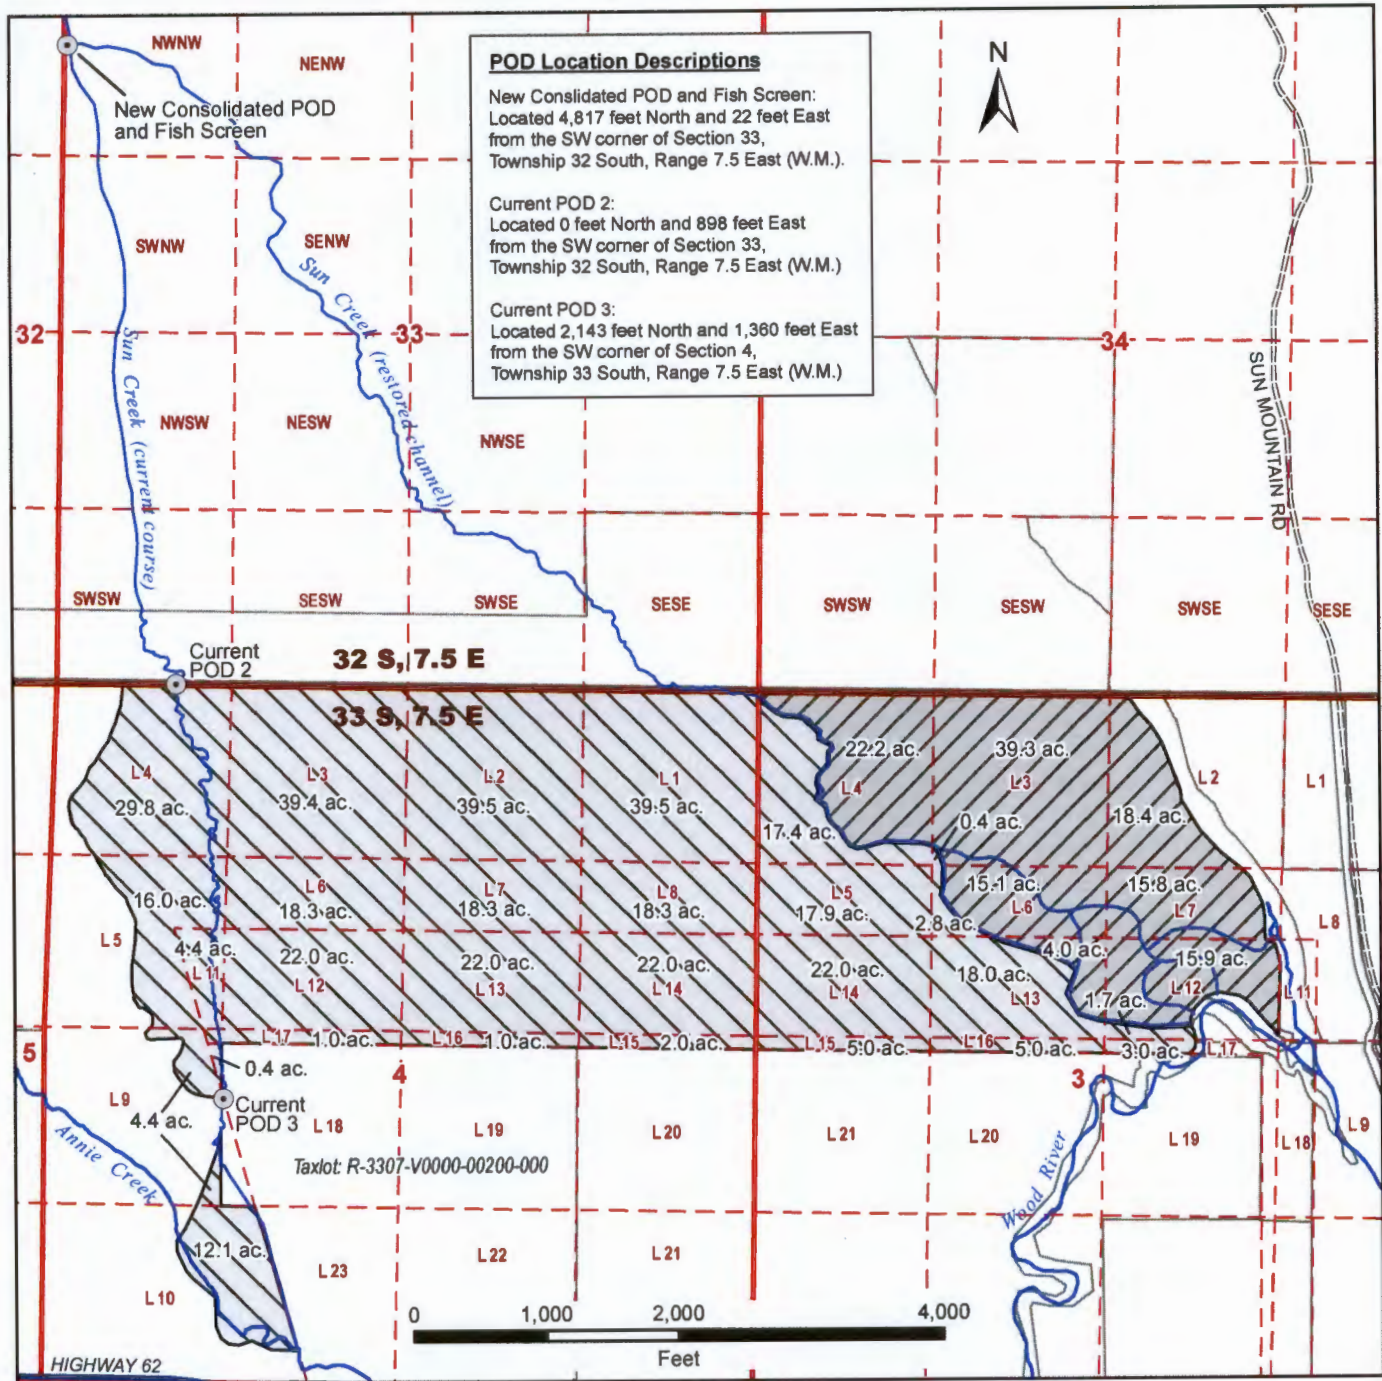

**Disclaimer**

This map was prepared for the purpose of identifying the location of a water right only and is not intended to provide legal dimensions or locations of property ownership lines.

**Map Notes**

Date Prepared: May 12, 2016  
 Prepared By: Southern Oregon GIS, LLC  
 Data Sources: USGS, USBLM, OWRD, OGDG, Klamath County GIS, Trout Unlimited  
 Map Projection: NAD\_1983\_HARN\_StatePlane\_Oregon\_South\_FIPS\_3602\_Feet\_Intl

RECEIVED BY OWRD

MAY 31 2016

SALEM, OR

**LEGEND**

- Authorized Point of Diversion (POD)
- Limited Access Road
- Stream
- Authorized Place of Use (POU) for Instream Transfer
- Authorized POU Remaining
- Klamath Co. Tax Lots

T 12400