

T-5668

RECEIVED

JUL 19 1985

WATER RESOURCES DEPT.
SALEM, OREGON


T. 29S. R. 5W. W.M.

Scale: 1" = 400 ft.

Proposed Div. Pt: 400' N. and 2100' W. from the
SE Cor. of DLC 48.



14 13
23 24

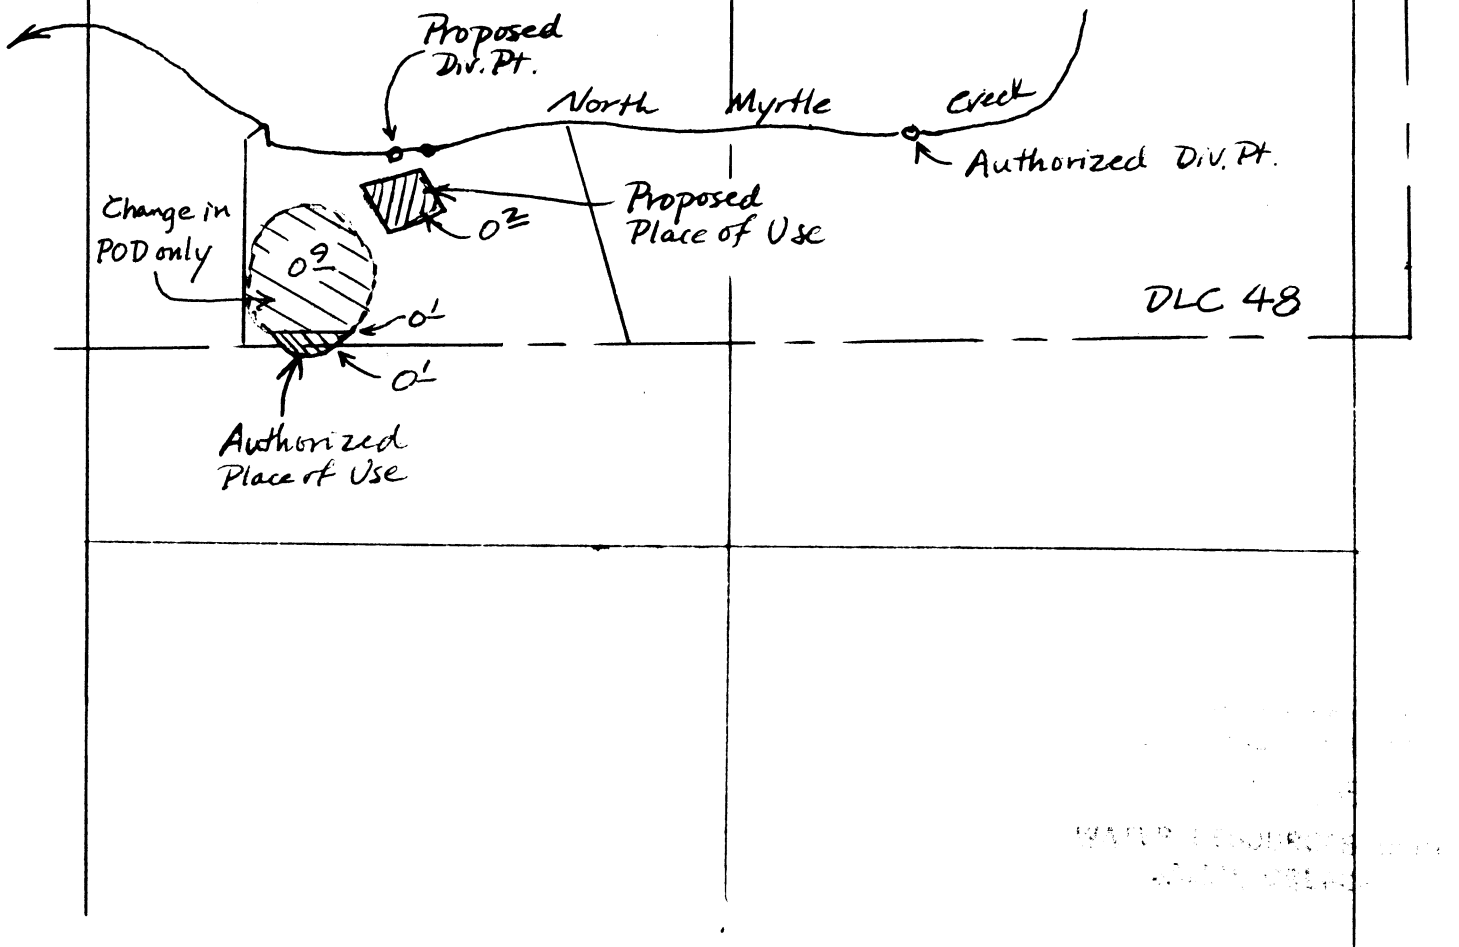

WATER RESOURCES DEPT.
SALEM, OREGON