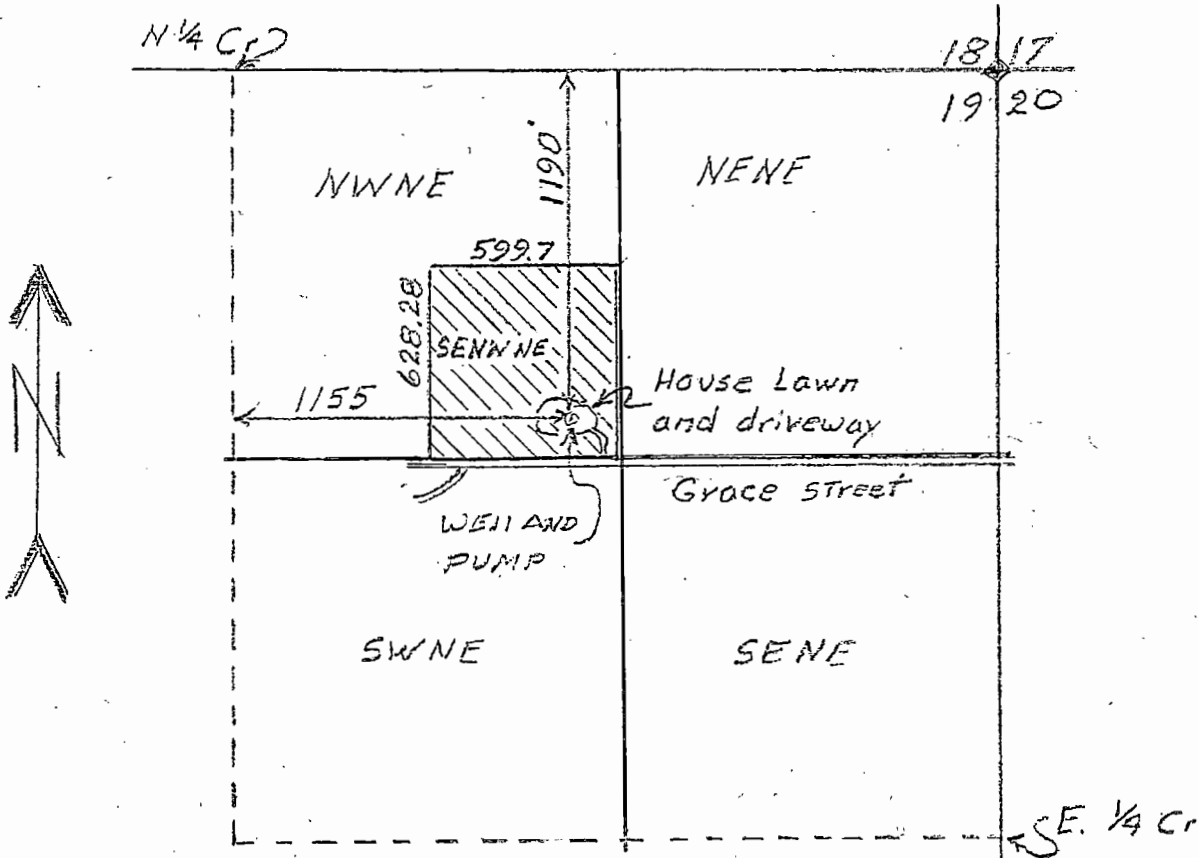
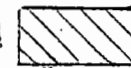
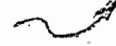

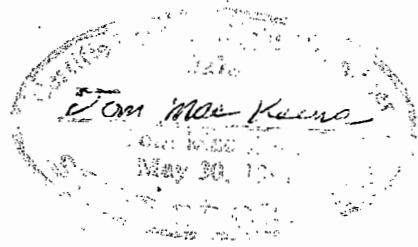


COBU MAP FOR PERMIT G-16669
 APPLICATION G17251 TAX 10T600
 T.9S.; R.40E.; W.M. S.19



LEGEND
 Land being irrigated  8.65 acres
 Property Line 
 Road 
 Drawn 12-12-12 TMK
 scale 1 inch = 660 ft



Meter located in garage
 approximately 125' south
 and west of well.

This map is for the purpose
 of identifying the water right
 location only and is not
 intended to provide legal
 dimensions or location
 of property ownership lines.

Map updated by JC @ WRD per CWRE request. 7/15/2013