

JOSEPHINE COUNTY

1" = 400'

SCALE 1" = 400'

T35S R7W Sec 13




RECEIVED BY OWRD

JUL 11 2016

SEE MAP

7 12

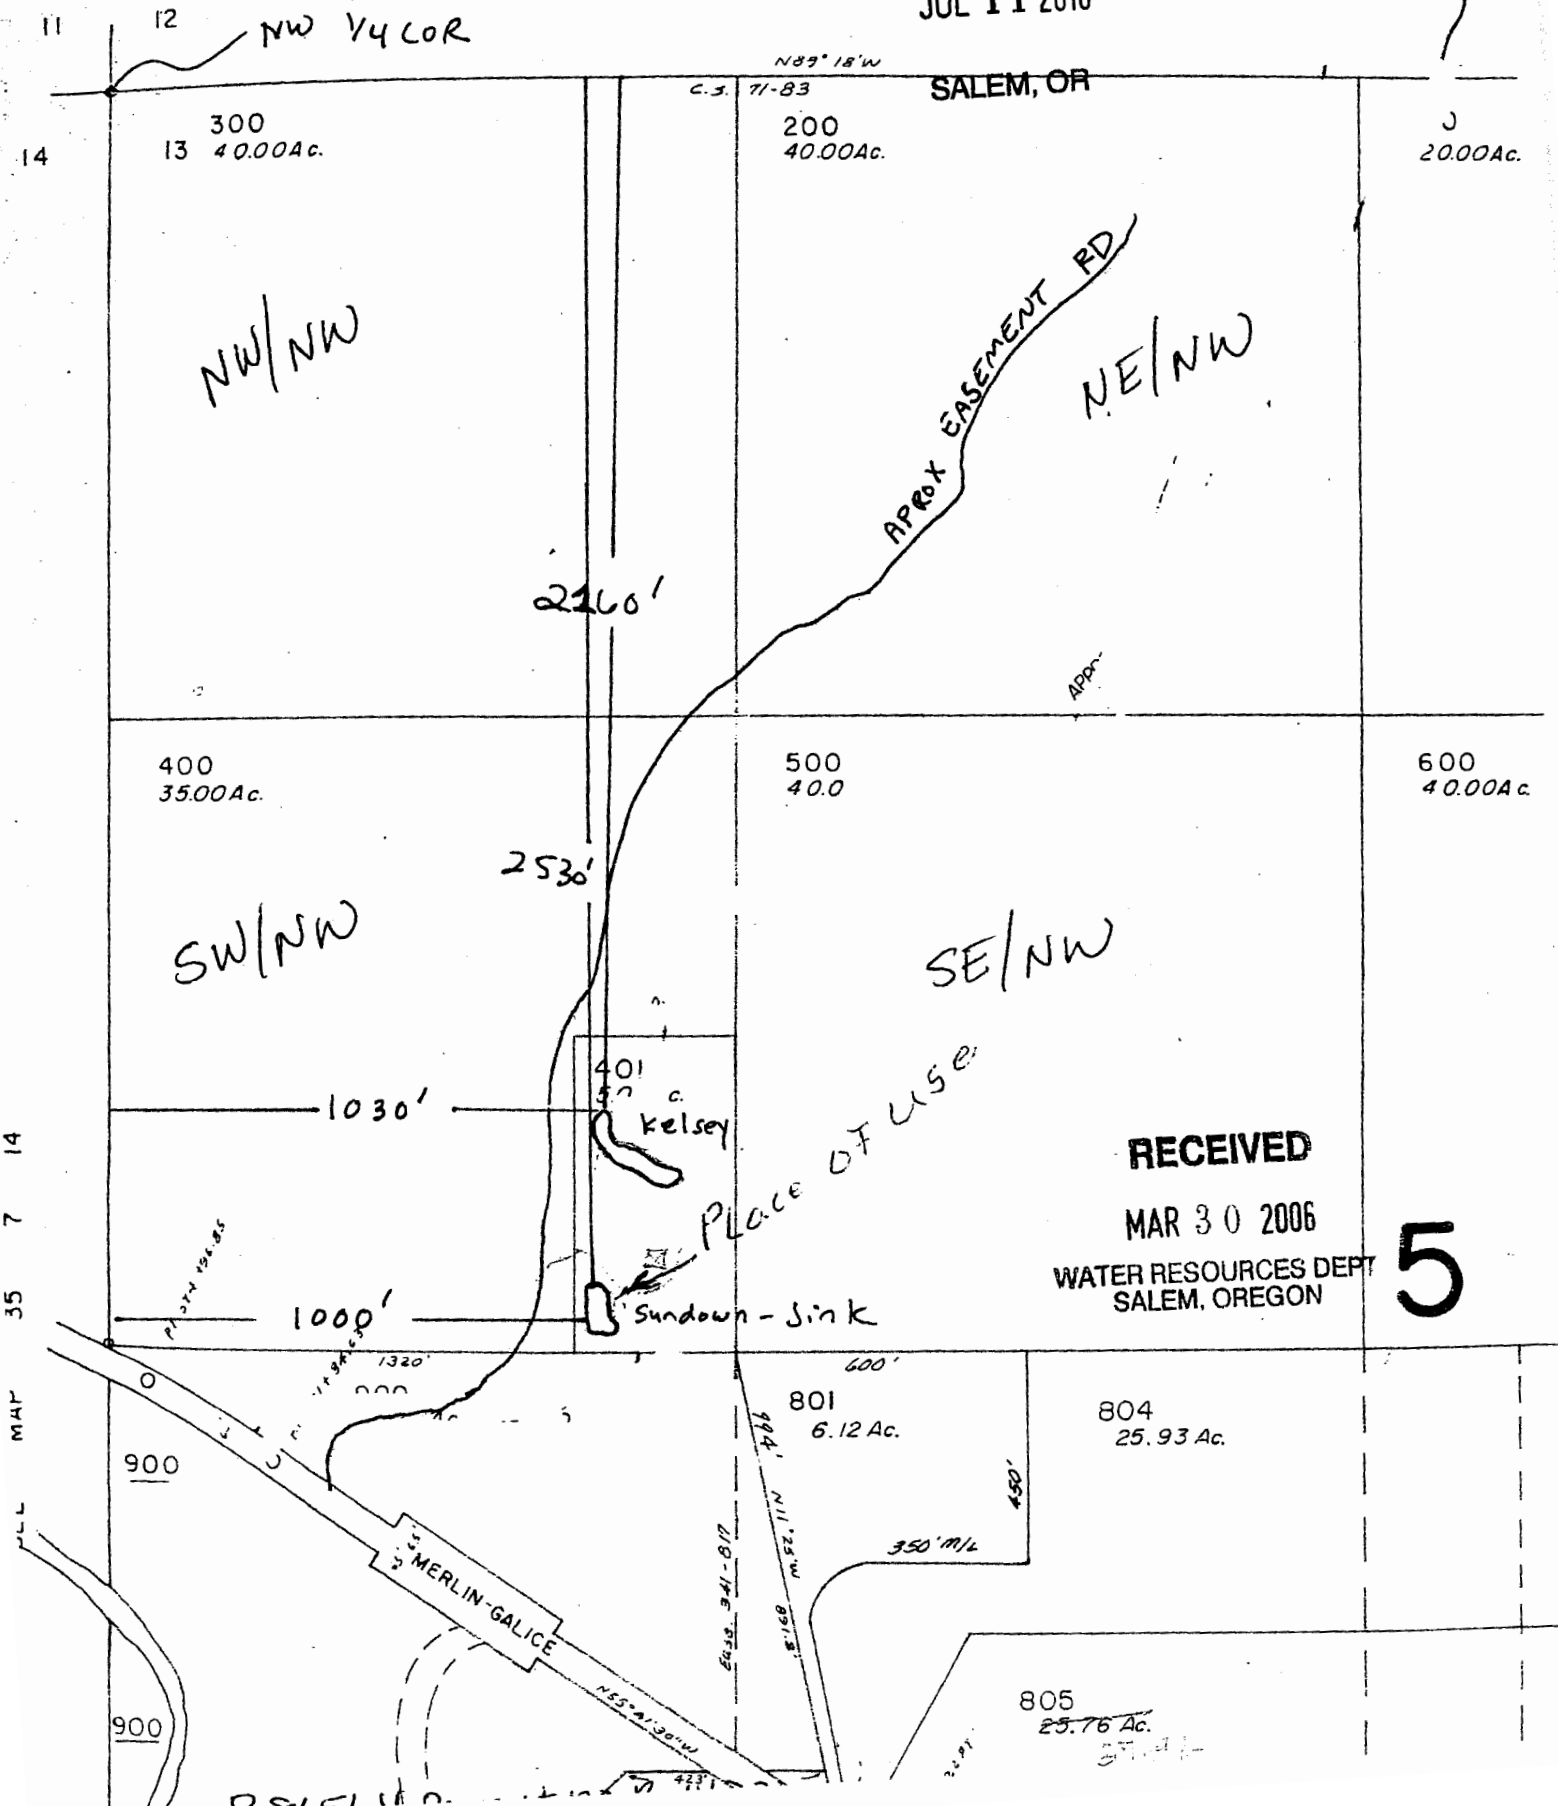

RECEIVED
 MAR 30 2006
 WATER RESOURCES DEPT
 SALEM, OREGON

5