


Final Proof Survey Map Myron Oberman NE 1/4 Sec. 5 T.25S. R.5W.

Douglas County Scale: 1" = 400'

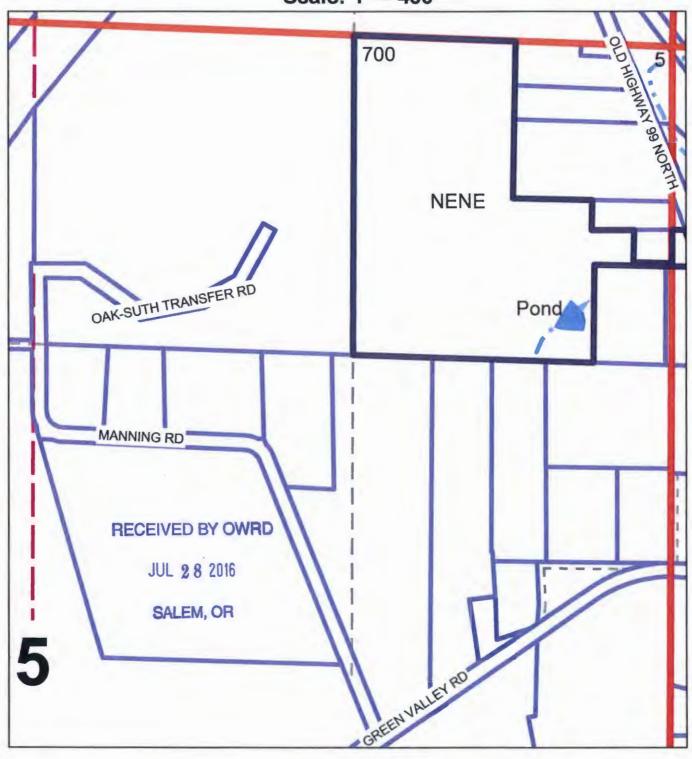

Pond is located 1120 ft. South and 420 ft. West from the NE Corner of Section 5.