


RECEIVED

JAN 05 2012

WATER RESOURCES DEPT
SALEM, OREGON

SECTION 20, T.7S., R.29E.

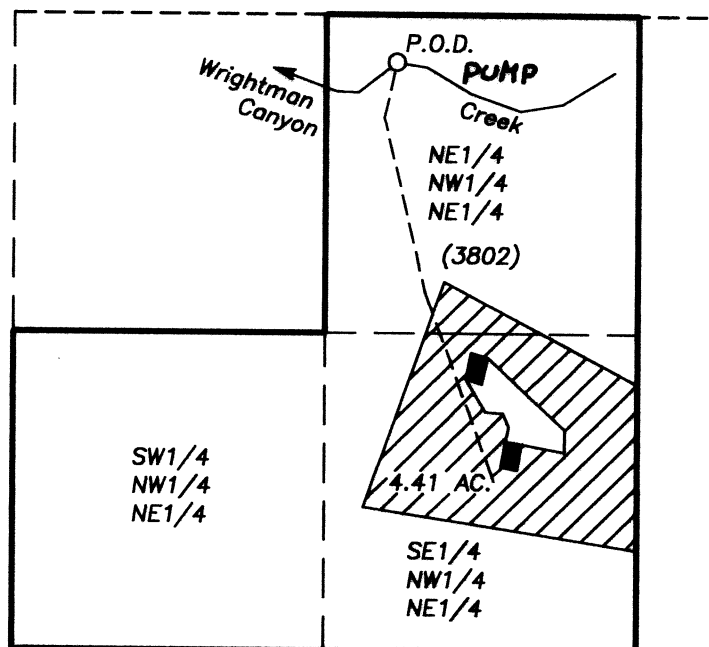

POD IS 5180' NORTH & 1820' WEST OF THE SE CORNER SECTION 20,
T.7S., R.29E., W.M. FOUND MARKED G.L.O. CORNER STONE.

○ P.O.D.

--- MAINLINE

▨ CURRENT PLACE OF USE

(3802) TAX LOT NO.



SCALE: 1" = 400'

FINAL PROOF SURVEY
UNDER
APPLICATION NO. 59330
PERMIT NO. 44611
IN NAME OF
TOM KILBY

DATE SURVEYED: SEPTEMBER 7, 2011

PREPARED BY:

ROBERT D. BAGETT, CWRE
217 N. CANYON BLVD.
JOHN DAY, OREGON 97845
(541) 575-1251

NOTE: THE PREPARATION OF THIS MAP
WAS FOR THE PURPOSE OF IDENTIFYING
THE LOCATION OF THE PROPOSED WATER
RIGHT AND HAS NO INTENT TO PROVIDE
DIMENSIONS OR LOCATION OF PROPERTY
OWNERSHIP LINES.

