


T.12S., R.41E., W.M.

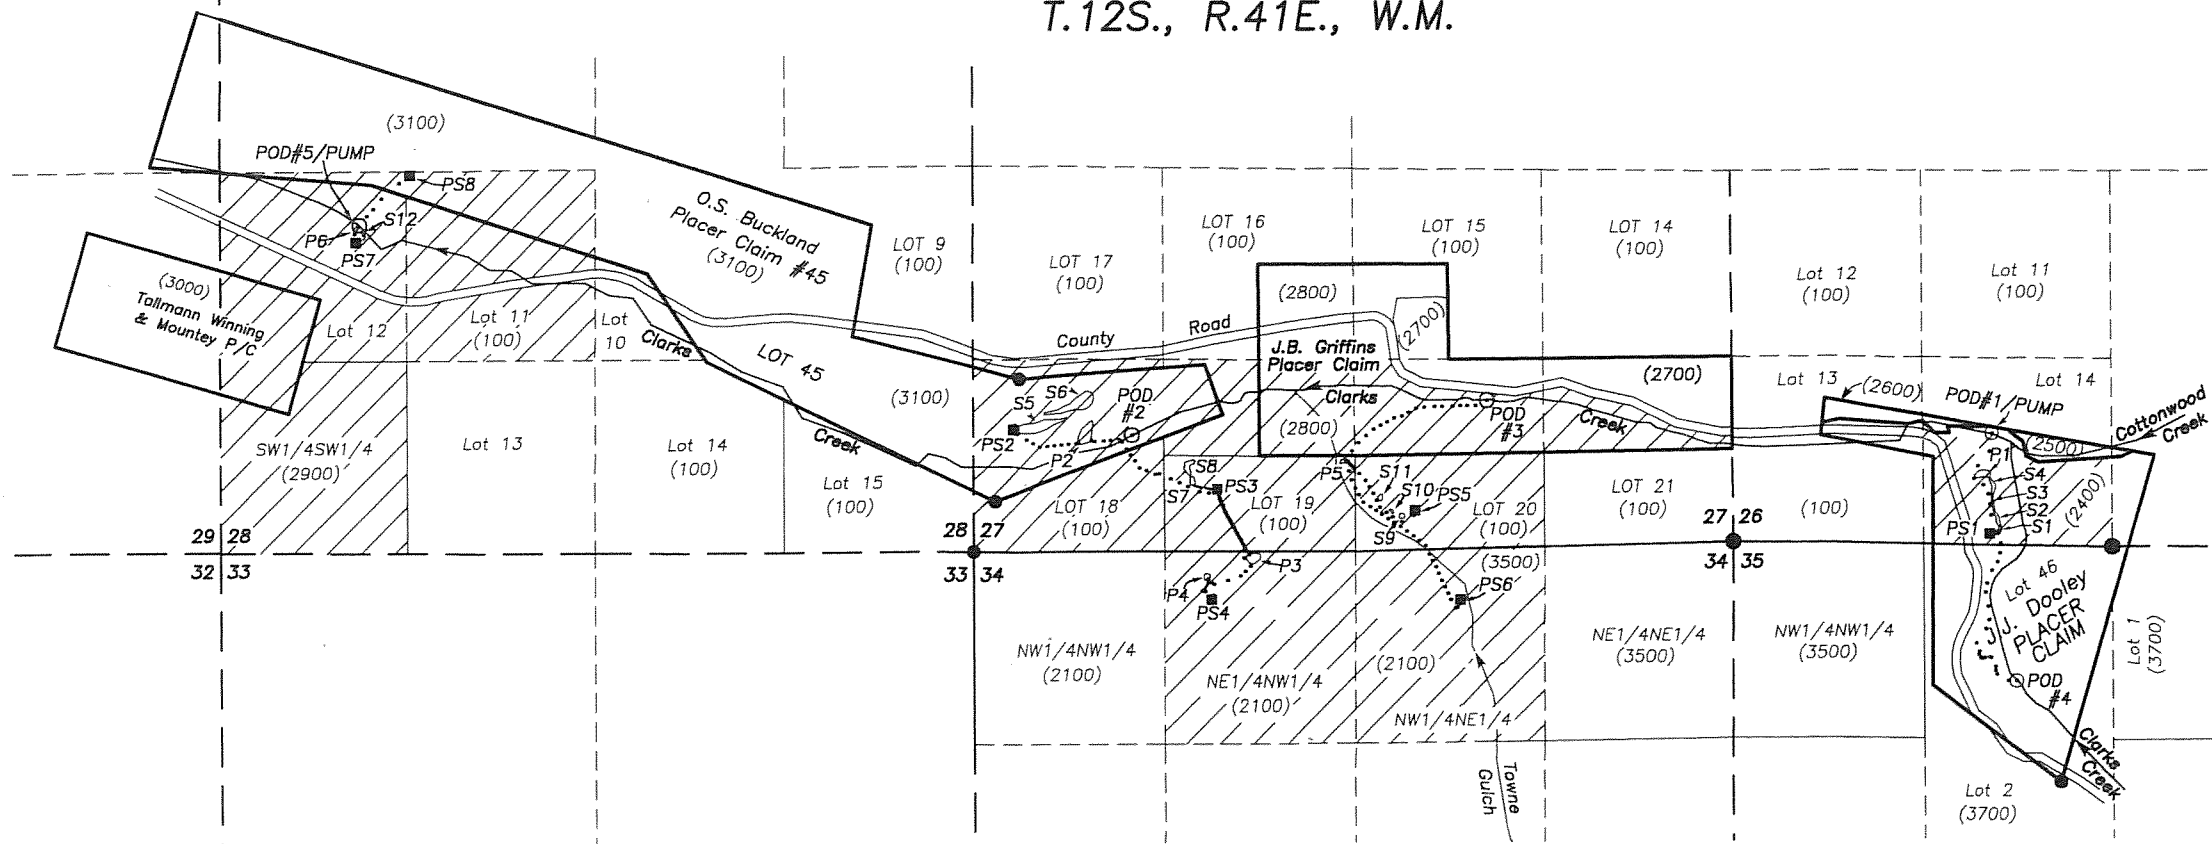

SCALE: 1"=1320'

RECEIVED

WATER RESOURCES DEPT
SALEM OREGON

POD #1 is 730 ft North and 1780 ft. East of the Southwest Corner Sec. 26
POD #2 is 790 ft North and 1090 ft. East of the Southwest Corner Sec. 27
POD #3 is 980 ft North and 1690 ft. West of the Southeast Corner Sec. 27
POD #4 is 970 ft South and 1950 ft. East of the Northwest Corner Sec. 35
POD #5 is 2250 ft North and 4220 ft. West of the Southeast Corner Sec. 28

FINAL PROOF SURVEY UNDER PERMIT NO. 46733

APPLICATION NO. 61214


FOR MINING

IN NAME OF
THREE VALLEYS RANCH, LLC
AND OTHERS

BY

ROBERT D. BAGETT
217 N. CANYON BLVD.
JOHN DAY, OREGON 97845

SURVEY COMPLETED: JULY 8, 2010

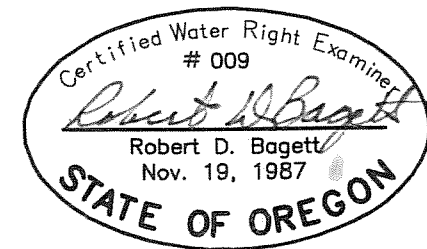

NOTE: The preparation of this map was for the purpose of identifying the location of the proposed water right and has no intent to provide dimensions or location of property ownership lines.

Place of Use

• Found marked stone monument

..... Pipe line

PS1 Plant site

P1 Pumping Pond -Bulge in system

S1 Settling pond

(100) Tax lot No.

COBU MAP # 0435
folder S