


CLAIM OF BENEFICIAL USE
 FOR RAYE OR TAYNA GUNTER
 BY DUANE W. KIRBY
 T21S, R4W, WM, SECTION 29
 APPLICATION NO S-71365
 PERMIT NO S-53106
 FISH SCREEN NOT REQUIRED
 TAX LOT NO 2100

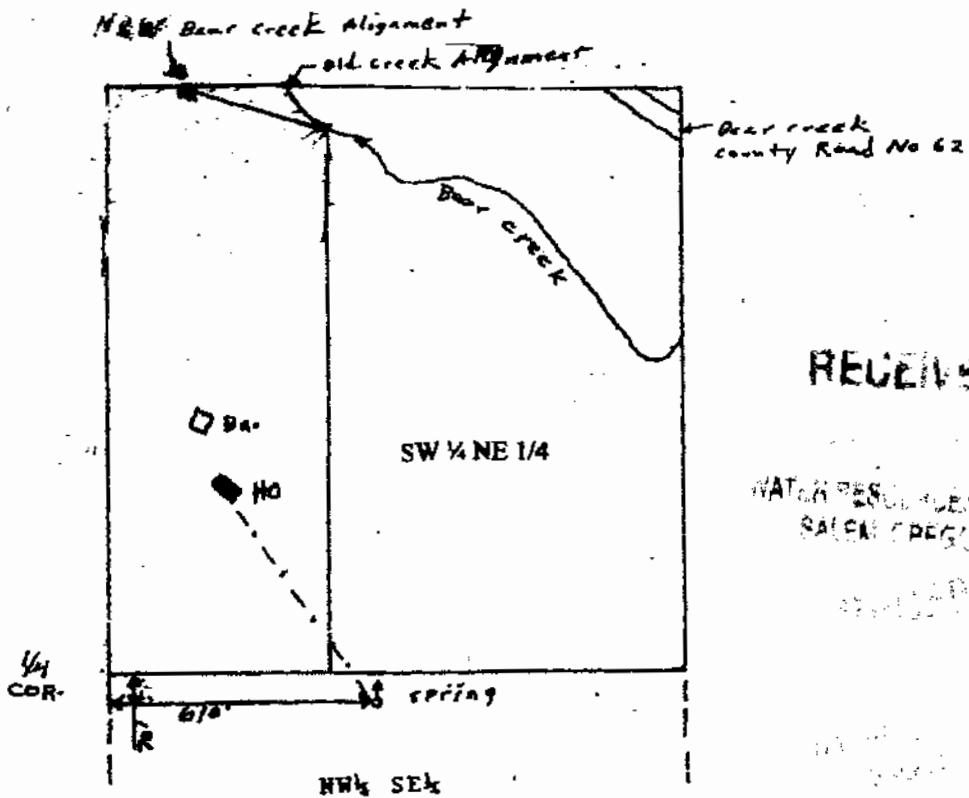

SCALE 1" = 400'



RECEIVED

WATER RESOURCES DIVISION
 SALEM, OREGON

THE PURPOSE OF THIS MAP IS TO IDENTIFY THE LOCATION OF THE WATER RIGHT. IT IS NOT INTENDED TO PROVIDE INFORMATION RELATIVE TO THE LOCATION OF PROPERTY OWNERSHIP BOUNDARY LINES.

