

CLAIM OF BENEFICIAL USE MAP

APPLICATION S-84754 PERMIT S-53835

PRIMARY AND SUPPLEMENTAL IRRIGATION AND FROST PROTECTION
FOR


GARVIN FAMILY LLC - VERN R. AND DOROTHY GARVIN

PO BOX 2282


HARBOR, OREGON 97415


SITUATED IN

SECTIONS 19 & 30, TOWNSHIP 35 SOUTH, RANGE 2 WEST, W.M.
JACKSON COUNTY, OREGON

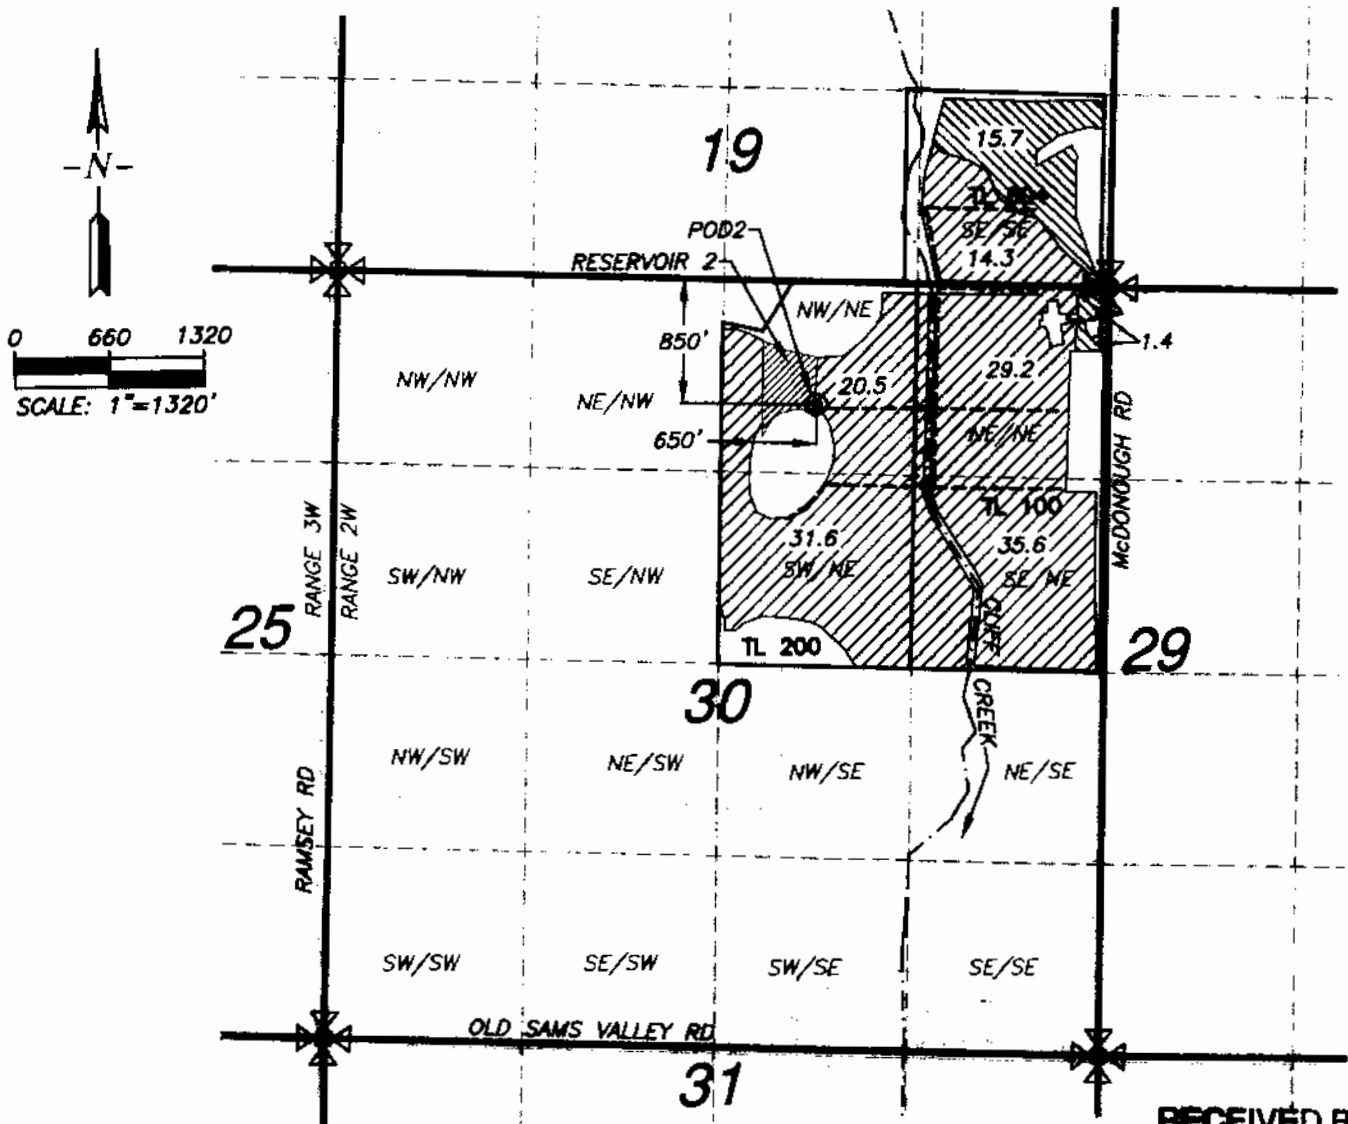

LEGEND

 -  POINT OF DIVERSION
-  PLACE OF USE (PRIMARY)
-  PLACE OF USE (SUPPLEMENTAL)
-  1/4-1/4 SECTION LINE
-  MAIN LINES-BURIED

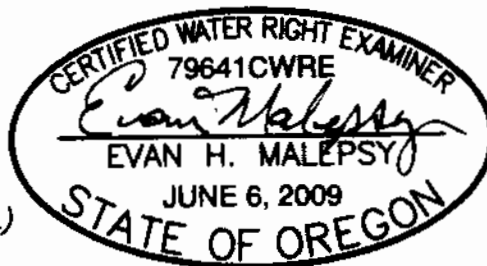

RENEWS: 12/31/2018

RECEIVED BY OWRD

FEB 21 2017

SALEM, OR

This map is not intended to provide
legal dimensions or locations of
property ownership lines.

EHM-September 20, 2012

Revised February 13, 2017 by: EHM