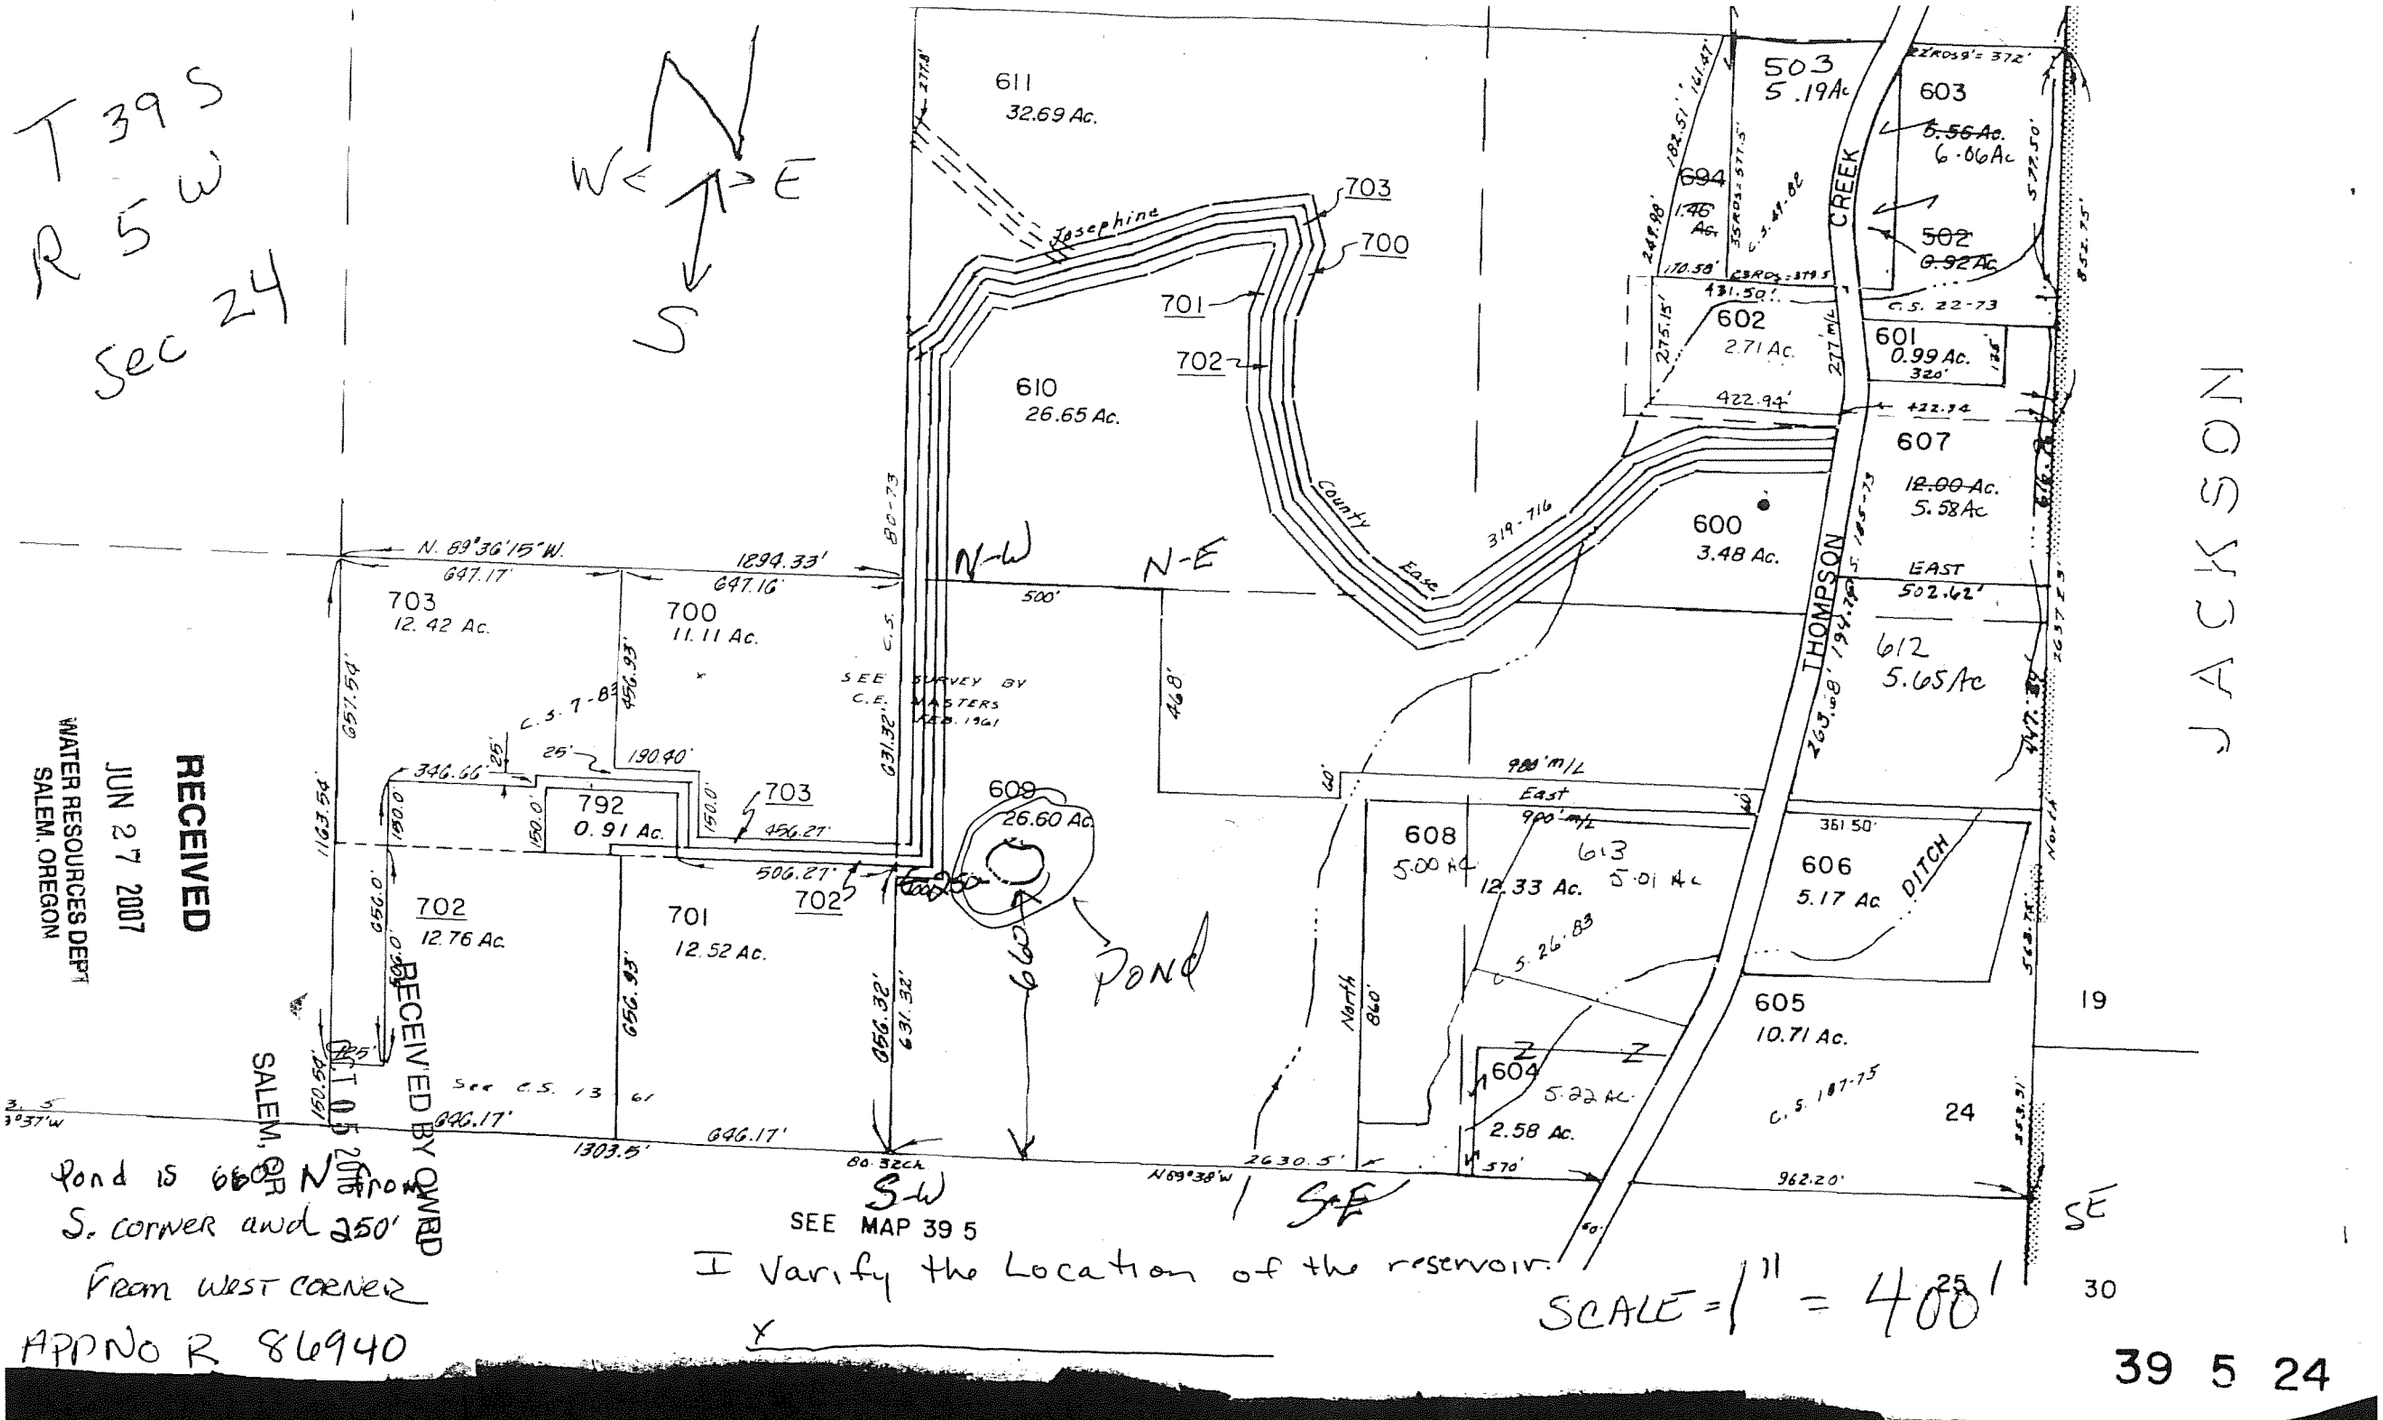

RECEIVED
JUN 27 2007
WATER RESOURCES DEPT
SALEM, OREGON

RECEIVED BY OWRD
OCT 05 2007
SALEM, OR

Pond is 660' N & 250' from S. corner and 250' From West corner

I Varify the Location of the reservoir.

SCALE = 1" = 400'

APP NO R 86940

39 5 24