


Howell Reservoir Application map
Township 2 South Range 40 East, W.M.

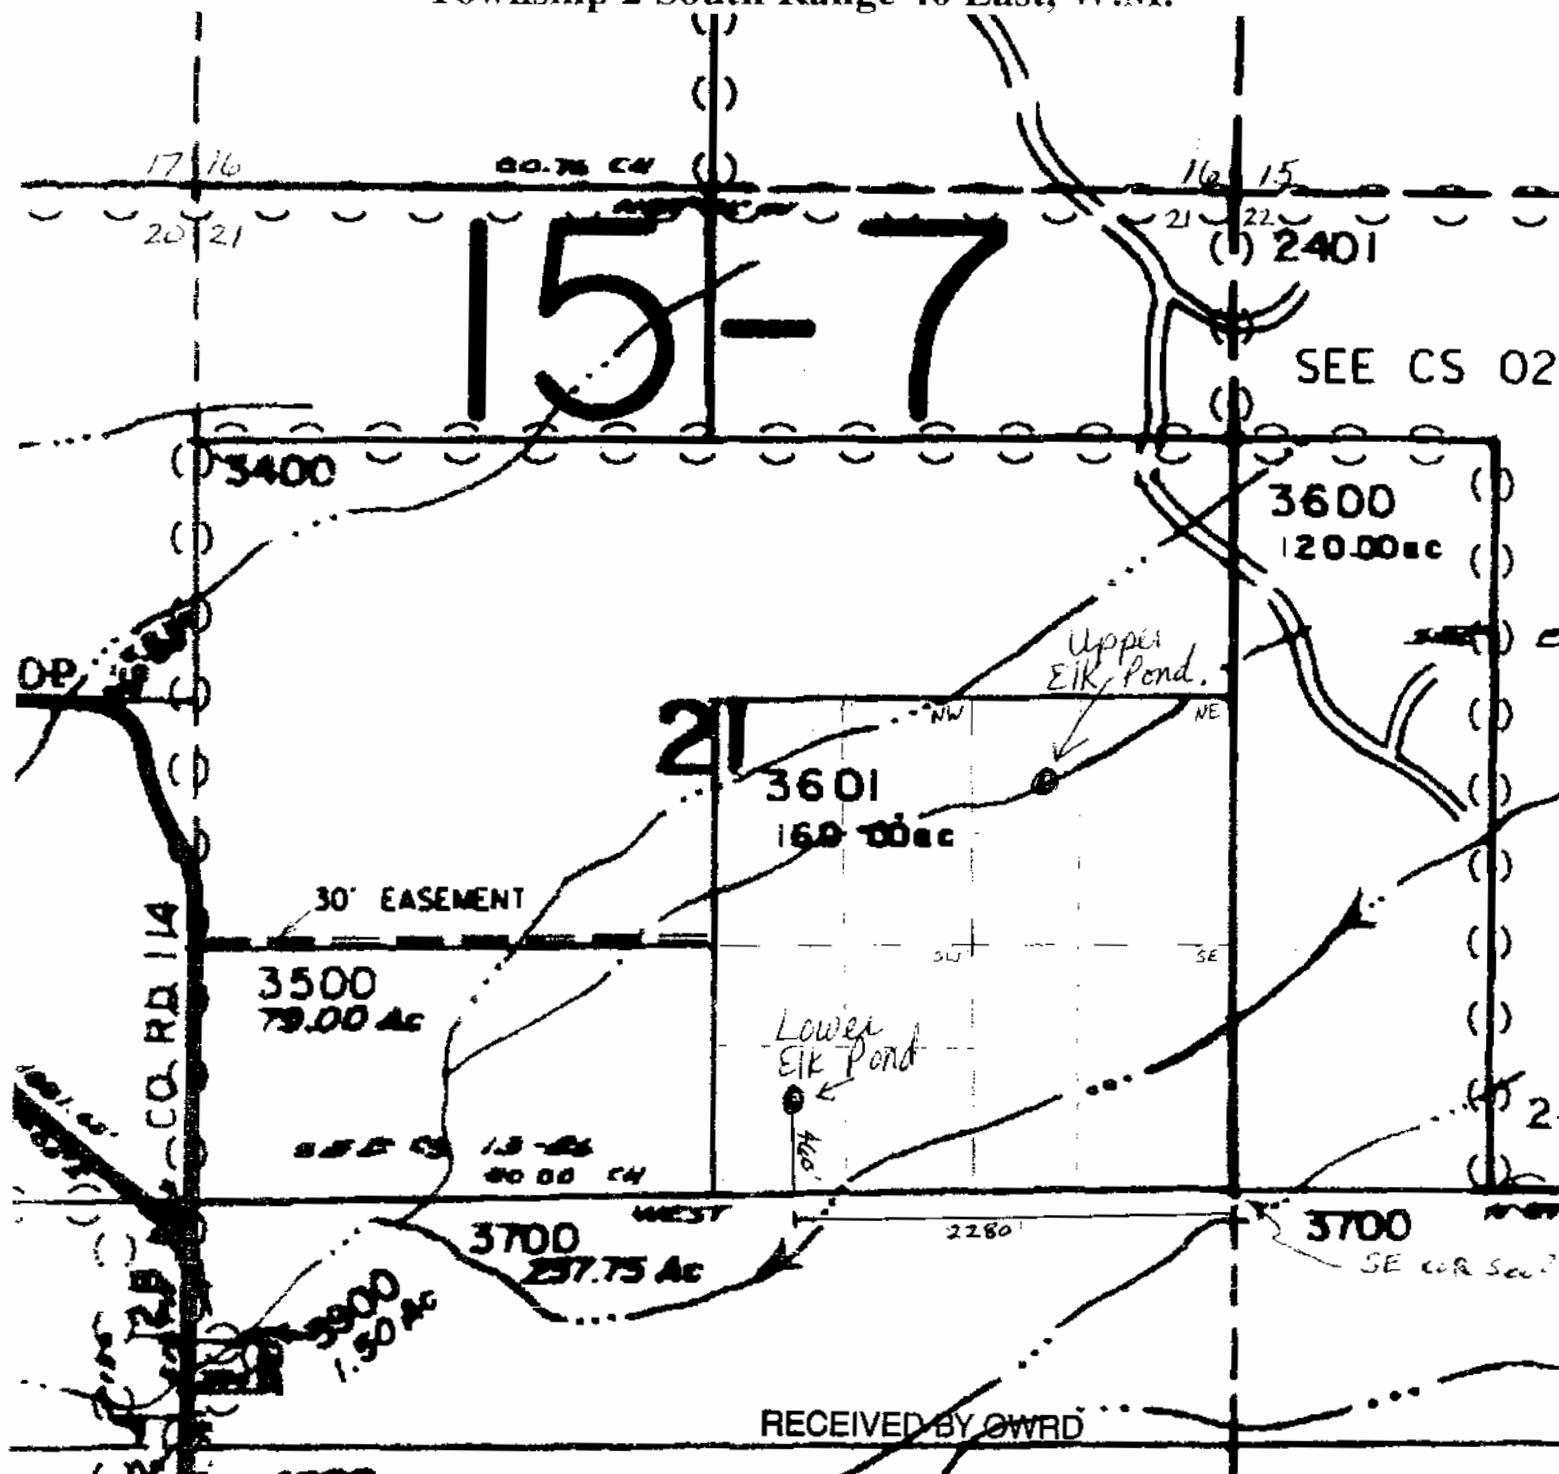

map scale 1" = 1000'

RECEIVED

AUG 14 2006

WATER RESOURCES DEPT
SALEM, OREGON

SEP 21 2016

SALEM, OR

RECEIVED
OVER THE COUNTRY

RECEIVED

JUN 29 2006

WATER RESOURCES DEPT
SALEM, OREGON

app no R-844444 permit no R 14394