


EXHIBIT B

T29S, R29½E, W.M.
Harney County, Oregon

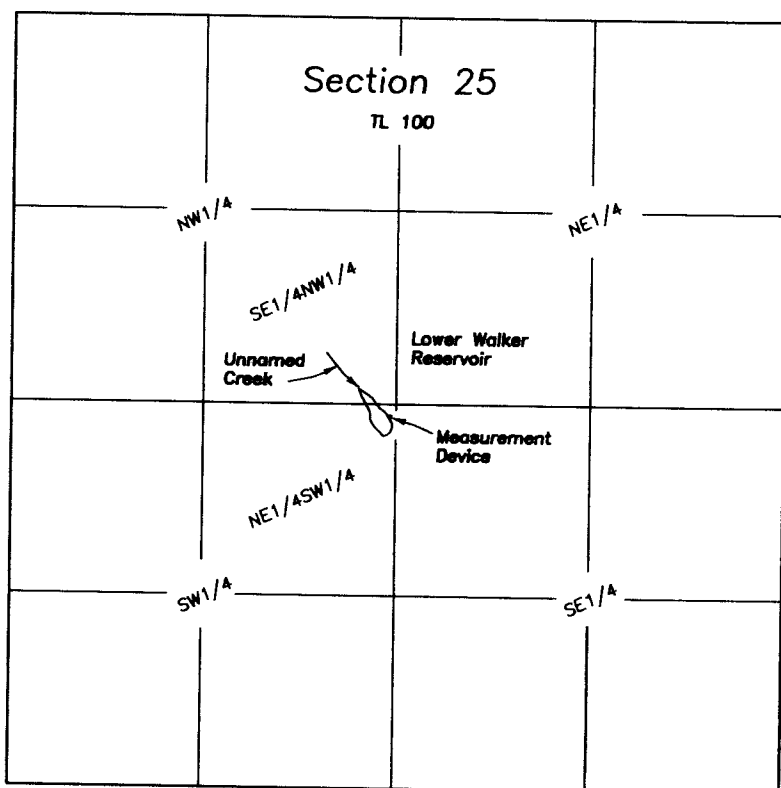

SCALE 1"=1320'

RECEIVED BY OWRD

FEB 06 2017

SALEM, OR

Outlet is located 2560' North & 2590' East of the
SW corner of Section 25.

Measuring device is located 12' South & 20' East of the Outlet.

FINAL PROOF SURVEY
CLAIM OF BENEFICIAL USE
LOWER WALKER RESERVOIR

For

Bureau of Land Management

November 17, 2016

Prepared by

Cornerstone Surveying, Inc

P.O. BOX 33

JOHN DAY, OR. 97845

(541)575-1813

cornerstonesurvey@centurytel.net

LEGEND

Application No. R-59630

Permit No. R-8067

Priority 12/21/1979

A portion of Tax Lot
29-29V TL100

NOTE: Tax Lot 100 is owned by the BLM
and is more that 23,000 acres.
No boundaries of the tax lot
can be shown.

NOTE: The preparation of this map
was for the purpose of identifying
the location of the proposed water
right and has no intent to provide
dimensions or location of property
ownership lines.

