


EXHIBIT B

T30S, R29³/₄E, W.M.
Harney County, Oregon

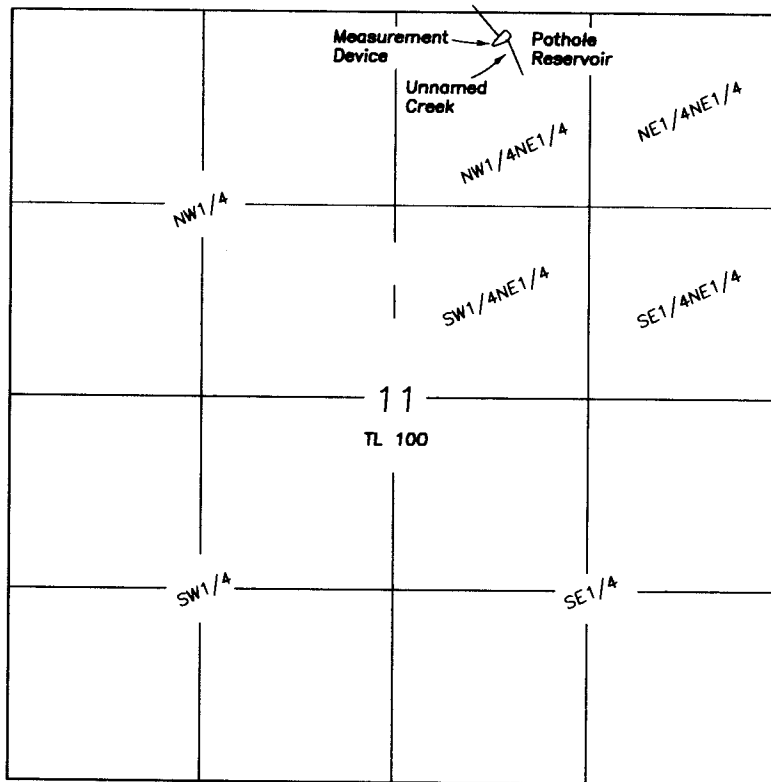

SCALE 1"=1320'

Outlet is located 220' South & 1990' West of the
NE corner of Section 11.

Measuring device is located 20' North of the Outlet.

FINAL PROOF SURVEY
CLAIM OF BENEFICIAL USE
POTHOLE RESERVOIR

For

Bureau of Land Managment

January 24, 2017

LEGEND

Application No. R-59665

Permit No. R-8097

Priority 12/21/1979

A portion of Tax Lot
30-29X TL100

NOTE: Tax Lot 100 is owned by the BLM
and is more that 8,300 acres.
No boundaries of the tax lot
can be shown.

NOTE: The preparation of this map
was for the purpose of identifying
the location of the proposed water
right and has no intent to provide
dimansions or location of property
ownership lines.

RECEIVED BY OWRD

FEB 06 2017

SALEM, OR

Prepared by

Cornerstone Surveying, Inc

P.O. BOX 33

JOHN DAY, OR. 97845

(541)575-1813

cornerstonesurvey@centurytel.net

