


EXHIBIT B

T30S, R29½E, W.M.
Harney County, Oregon

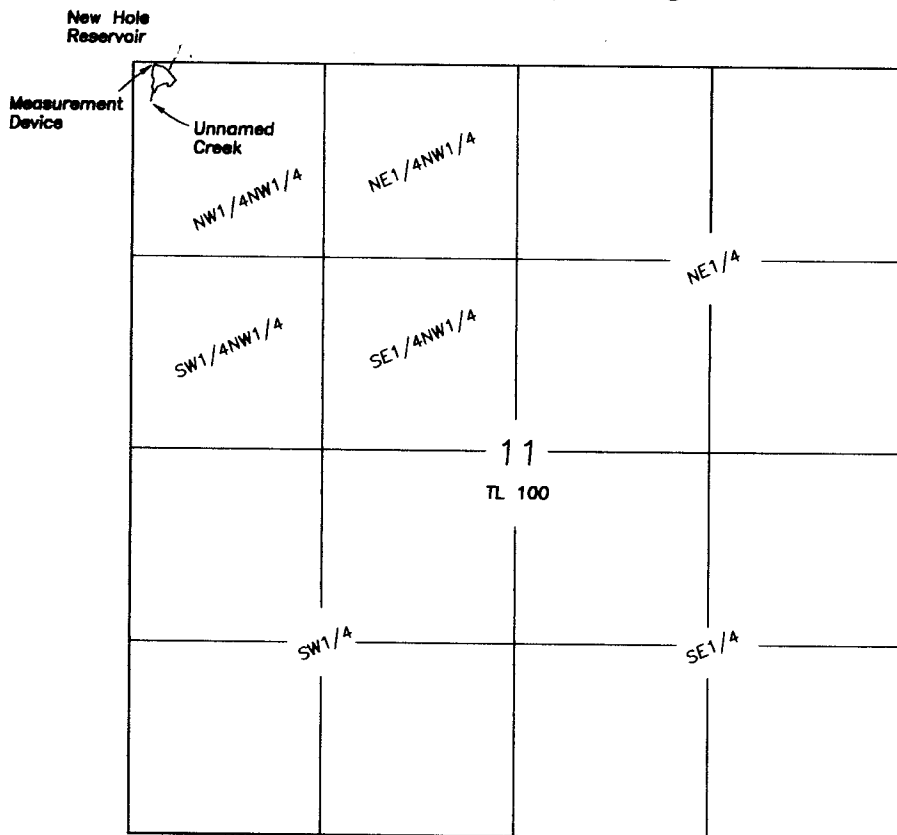

Outlet is located 10' South & 150' East of the
NW corner of Section 11.

Measuring device is located 8' North & 6' West of the Outlet.

FINAL PROOF SURVEY
CLAIM OF BENEFICIAL USE
NEW HOLE RESERVOIR

For

Bureau of Land Management

January 24, 2017

LEGEND

Application No. R-59661

Permit No. R-8093

Priority 12/21/1979

A portion of Tax Lot
30-29V TL100

NOTE: Tax Lot 100 is owned by the BLM
and is more that 23,000 acres.
No boundaries of the tax lot
can be shown.

NOTE: The preparation of this map
was for the purpose of identifying
the location of the proposed water
right and has no intent to provide
dimensions or location of property
ownership lines.

RECEIVED BY OWRD

FEB 06 2017

SALEM, OR

Prepared by
Cornerstone Surveying, Inc

P.O. BOX 33

JOHN DAY, OR. 97845

(541)575-1813

cornerstonesurvey@centurytel.net

