


EXHIBIT B

T29S, R29³/₄E, W.M.
Harney County, Oregon

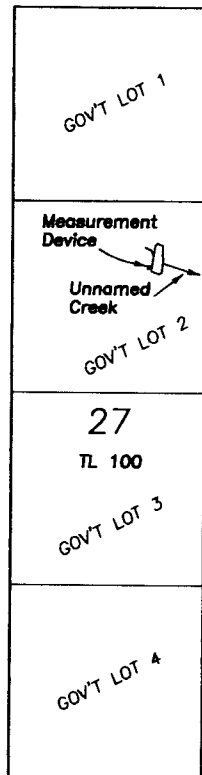

NOTE: Section 27 only contains
Gov't Lots 1, 2, 3 and 4 only.

Larry's Reservoir



SCALE 1"=1320'

Outlet is located 1790' South & 380' West of the
NE corner of Section 27.

Measuring device is located 4' North & 37' East of the Outlet.

FINAL PROOF SURVEY
CLAIM OF BENEFICIAL USE
LARRY'S RESERVOIR

For

Bureau of Land Management

January 24, 2017

LEGEND

Application No. R-59631

Permit No. R-8068

Priority 12/21/1979

A portion of Tax Lot
29-29X TL100

NOTE: Tax Lot 100 is owned by the BLM
and is more that 8,300 acres.
No boundaries of the tax lot
can be shown.

Prepared by

Cornerstone Surveying, Inc

P.O. BOX 33

JOHN DAY, OR. 97845

(541)575-1813

cornerstonesurvey@centurytel.net

NOTE: The preparation of this map
was for the purpose of identifying
the location of the proposed water
right and has no intent to provide
dimensions or location of property
ownership lines.

RECEIVED BY OWRD

FEB 06 2017

SALEM, OR

