


**Map of Claim of Beneficial Use
Application G-16934
Permit G-16408**

T 35 S, R 2 W, Sec. 12, W.M.
Leonard & Caroll Ferrara

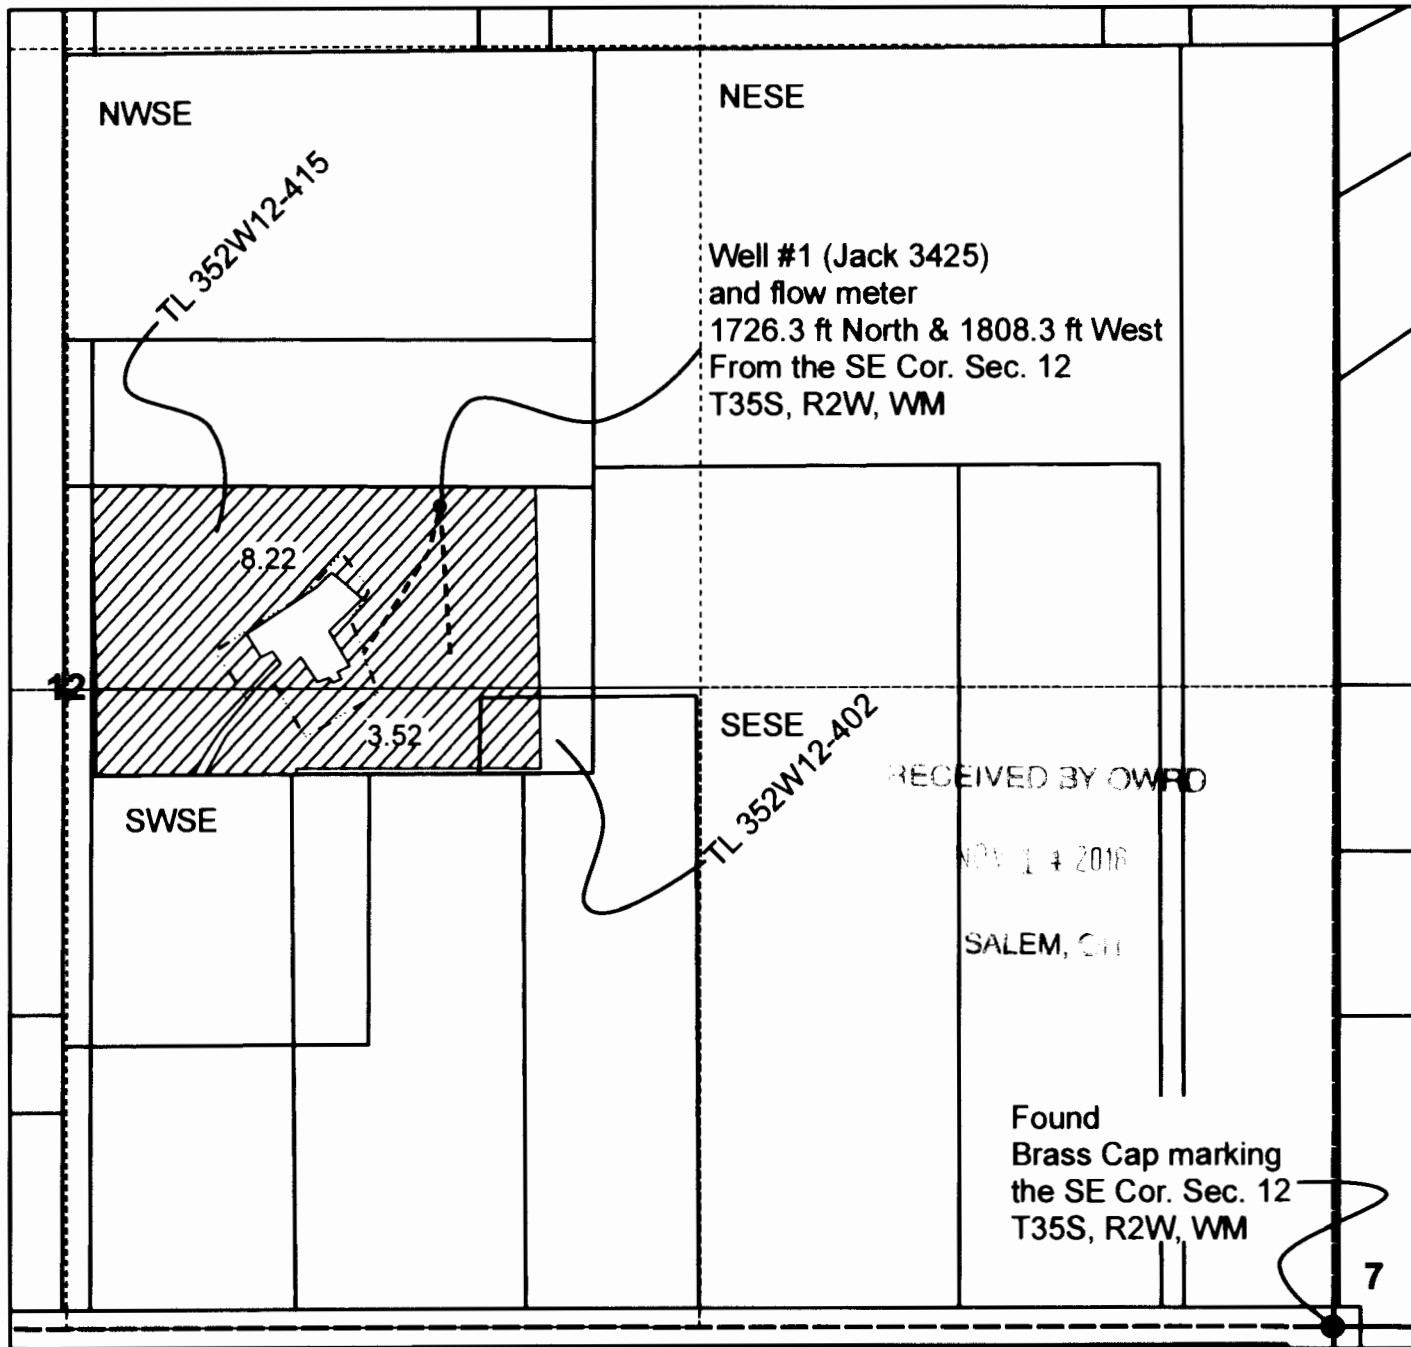

Legend

-  Irrigated
-  Main Line
-  Lateral lines



1 inch = 400 feet

Note: This map is not intended to provide legal dimensions or locations of property ownership lines.

