



T.5S., R.4W., W.M.

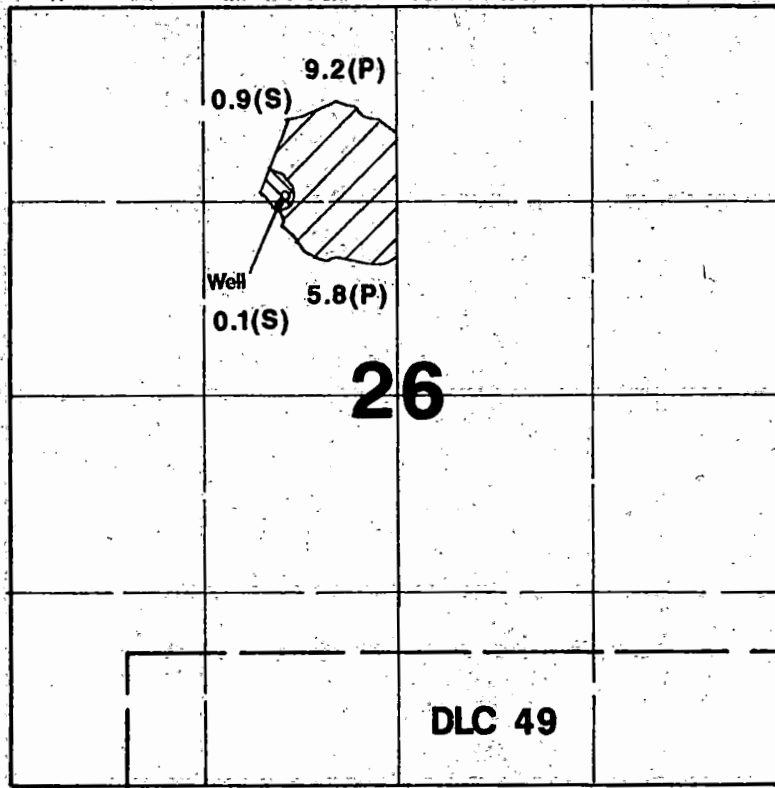

Well located 1300'S & 1880'E from NW corner of Section 26.

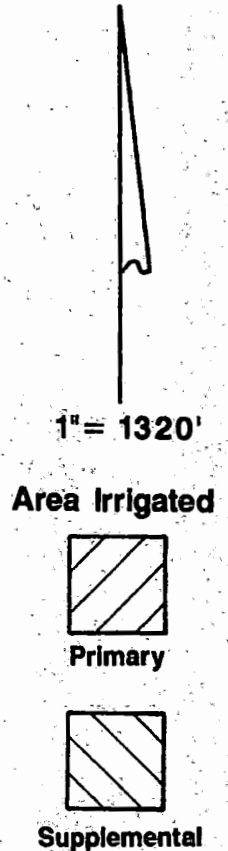

Final Proof Survey

Application #: G-12374 Permit #: G-11491

In Name Of

Fred & E. Diane Zeitoun

Surveyed on October 4, 1995 by JM Grimm

RECEIVED

JAN 23 1996

WATER RESOURCES DEPT.
SALEM, OREGON



THIS MAP WAS PREPARED FOR THE PURPOSE OF IDENTIFYING THE LOCATION OF A WATER RIGHT ONLY AND IS NOT INTENDED TO PROVIDE LEGAL DIMENSIONS OR LOCATION OF PROPERTY OWNERSHIP LINES.